

MAR 23 2000

REMONUMENTATION

LAND CORNER RECORDATION CERTIFICATE
Filing Requirement of Act 74, Mich. P.A. 1970

SECTION

For corners in

Lapeer

(County)

Located In:

Attica Township

Corner Code #

1. Public Land Survey

T7N R11E A-12

T R

T R

T R

S T R

S T R

S T R

S T R

2. Property Controlling in Section

3. Miscellaneous Property in Sec.

4. Lot No. _____, Recorded Plat _____

5. Private Claims _____

RECEIVED FOR RECORD

99 DEC 14 AM 9:08

Melissa ...
REGISTER OF DEEDS
LAPEER COUNTY, MICHIGAN

509

Register of Deeds Stamp & File Number

	A	B	C	D	E	F	G	H	I	J	K	L	M
1													
2	6		5		4		3		2		1		
3													
4	7		8		9		10		11		12		
5													
6	10		17		16		15		14		13		
7													
8	19		20		21		22		23		24		
9													
10	30		29		28		27		26		25		
11													
12	31		32		33		34		35		36		
13													

I, Huston K. Kennedy, in a field survey on August 5, 1999 do hereby state that under requirements of P.A. 74, Michigan P.A. of 1970, the corner points mentioned in lines 1 and 2 above were in conformance with regulations and rules therefore as required in the current manual of survey instructions of the United States Department of the Interior, Bureau of Land Management or by a decree of a Court of Law and/or that the corner points mentioned in lines 3, 4 and 5 above were in conformance with the rules of the Michigan Board of Land Surveyors or by a Decree of a Court of Law; established, re-established, monumented, recovered, found as expressed below:

NOTE: Not more than 2 corners, all in the same town and range, may be recorded on this certificate.

- A. Description of original monument and accessories and/or subsequent restoration:
 - 1831-GLO Lynn, D.S. & Sibley, D.S.; No post set, no witnesses
 - 1.) 1993-Elrich, PS #18986; LCRC for (M-12 Lapeer Twp.) L.5, Pg.23 - Fnd a 1/2" Iron Rod
 - 2.) 1976-Henderson, PS #16043; Survey L.003, Pgs.516-521 - Set a 1/2" Iron Rod
 - 3.) 1985-Henderson, PS #16043; Survey L.006, Pgs. 890 & 891 - Object found not stated

B. Description of corner evidence found and/or method applied in restoring or reestablishing corner:
1999-Kennedy Surveying, Inc. - Kennedy, PS #17623 - Fnd a 1/2" Iron Rod located 7 feet East of the existing centerline of Five Lakes Road extending to the North & South, which has a gravel surface, an old fence-rock row extending to the East. East 1/4 corner of Section 36, T7N, R10E, Lapeer Township (M-12) is located 50.18 feet to the North. A-12 as found is 0.14 feet West of the range line.

Witnesses from Survey #2 & 3 were used to recover and verify the location of the found 1/2" Iron Rod.
I accepted the found 1/2" Iron Rod as the best evidence of the original corner position.

FIELD MEASUREMENTS BETWEEN

A-12 to A-3
No GLO
Survey recorded in Liber 003, pages 516-521 dated 6/9/75 (Sec 31) = 2634.00 Ft.
Survey recorded in Liber 006, pages 890 & 891 (Sec 31) dated 12/4/84 = 2634.00 Ft.
2634.12 Ft. (MEA 1999)



(Can't on back side)

- C. Description of monument for corner and accessories established to perpetuate locating the position of the corner:
A-12 I replaced the found 1/2" Iron Rod with a 1/2" X 24" Iron Rod w/2" diameter brass cap stamped Lapeer County
Remonumentation #17623
N30°E 38.21' Set Mag Nail & Remon Washer NW face 28" Oak
N22°W 102.75' Set Mag Nail & Remon Washer East face 33" Oak
S38°W 72.35' Set Mag Nail & Remon Washer SE face 17" Oak
S22°E 37.55' Set Mag Nail & Remon Washer West face 37" clump of Willow
North 50.18' East 1/4 corner of Section 36, T7N, R10E, Lapeer Township (M-12)
East 33.00' Fnd a 1/2" capped Iron Rod

The selected location is accepted by me and is generally accepted by Professional Surveyors as the best available evidence of the position of the original corner.

Signed by: [Signature]
Surveyor's Michigan License No. 17623

Date 11-22-99

SURVEY &
REMONUMENTATION

MAR 23 2000

SECTION

Town 7 North, Range 11 East, Attica Township A-12

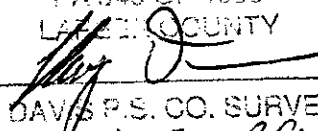
A-12 to A-11

No GLO
No recorded distances
2641.15 Ft. (MEA 1999)

A-12 to M-12

No GLO
LCRC recorded in L.5, Pg.23 dated 12/22/93 = 50.05 Ft.
50.18 Ft. (MEA 1999)

PEER GROUP
APPROVED LAND CORNER
PA 345 OF 1990


RAY DAVIS P.S. CO. SURVEYOR
DATE 10-21-99

MISC 3 9.00
REMLC 90075
REMONT 2.00