

SURVEY &  
REMONUMENTATION

1993

COMMISSION

REMONUMENTATION  
LAND CORNER RECORDATION CERTIFICATE  
Filing Requirement of Act 74, Mich. P.A. 1970

RECEIVED FOR RECORD

93 DEC 22 PM 2:36

LIBER NO. 5 PAGE NO. 1

*Melissa Miles*  
REGISTER OF DEEDS  
LAPEER COUNTY, MICHIGAN

For corners in

LAPEER  
(County)

Located In: Attica Township  
Corner Code # M-10

- |                                       |                          |             |
|---------------------------------------|--------------------------|-------------|
| 1. Public Land Survey                 | T <u>7N</u> R <u>11E</u> | <u>M-10</u> |
|                                       | T _____ R _____          | _____       |
|                                       | T _____ R _____          | _____       |
|                                       | T _____ R _____          | _____       |
| 2. Property Controlling in Section    | S _____ T _____ R _____  | _____       |
|                                       | S _____ T _____ R _____  | _____       |
| 3. Miscellaneous Property in Sec.     | S _____ T _____ R _____  | _____       |
|                                       | S _____ T _____ R _____  | _____       |
| 4. Lot No. _____, Recorded Plat _____ |                          |             |
| 5. Private Claims _____               |                          |             |

Register of Deeds Stamp & File Number

	A	B	C	D	E	F	G	H	I	J	K	L	M
2	6	5	4	3	2	1							
3													
4	7	8	9	10	11	12							
5													
6	18	17	16	15	14	13							
7													
8	19	20	21	22	23	24							
9													
10	30	29	28	27	26	25							
11													
12	31	32	33	34	35	36							
13													

I, Shelby W. Money, in a field survey on October 12, 1993, do hereby certify that under requirements of P.A. 74, Michigan P.A. of 1970, the corner points mentioned in lines 1 and 2 above were in conformance with regulations and rules therefore as required in the current manual of survey instructions of the United States Department of the Interior, Bureau of Land Management or by a decree of a Court of Law and/or that the corner points mentioned in lines 3, 4 and 5 above were in conformance with the rules of the Michigan Board of Land Surveyors or by a Decree of a Court of Law; established, re-established, monumented, re-monumented, recovered, found as expressed below:

**NOTE: Not more than 4 corners, all in the same town and range, may be recorded on this certificate.**

A. Description of original monument and accessories and/or subsequent restoration:


- G.L.O. set post 1817
- Stake located by Bates 1867
- 1/2" Rebar found by Kay 1973
- 5/8" Rod with 1 1/2" disk stamped MDSH&T RLS19841 - 1976
- 1/2" Rebar found by Kay 1979
- 1/2" Rebar found by Elrich 1987

B. Description of corner evidence found and/or method applied in restoring or reestablishing corner:

- Found 1/2" Rebar, 6" deep, using witnesses from:
  - 1973 Survey by Kay L.1 P.912 30" Maple & 24" Maple (no nails)
  - 1976 L.C.R.C. by Houth L.3 P.276 30" Maple & 24" Maple (no nails)
  - 1979 Survey by Kay L.5 P.235 30" Maple & 24" Maple (no nails)
  - 1987 Survey by Elrich L.7 P.506 Found all witnesses

C. Description of monument for corner and accessories established to perpetuate locating the position of the corner:

- Concrete Monument S 65° W 36.47' (Old witness)
- Concrete Monument S 65° E 35.47' (Old witness)
- Set Lapeer tag/nail in north face of 26" Maple N 85° W 122.05' (Old witness)
- Set Lapeer tag/nail in west face of 31" Maple N 20° E 177.25' (Old witness)
- Northeast corner bridge abutment wingwall at ground S 20° W 136.55'
- Northwest corner bridge abutment wingwall at ground S 20° E 136.50'
- SET LAPEER COUNTY REMONUMENTATION BRASS CAP MARKED 30092 / M-10 OVER EXISTING ERROR

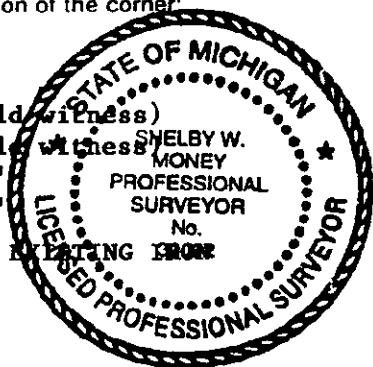

Signed by *Shelby W. Money* Date December 21, 1993

Surveyor's Michigan License No. 30092