

SURVEY &
REMONUMENTATION

1993

COMMISSION

REMONUMENTATION
LAND CORNER RECORDATION CERTIFICATE
Filing Requirement of Act 74, Mich. P.A. 1970

RECEIVED FOR RECORD

93 DEC 22 PM 2:37

LIBER NO. 5 PAGE NO. 2
Melissa Miles
REGISTERED DEEDS
LAPEER COUNTY, MICHIGAN

For corners in

LAPEER
(County)

Located In: Attica Township Corner Code ##

- | | | |
|---------------------------------------|--------------------------|-------------|
| 1. Public Land Survey | T <u>7N</u> R <u>11E</u> | <u>M-11</u> |
| | T _____ R _____ | _____ |
| | T _____ R _____ | _____ |
| | T _____ R _____ | _____ |
| 2. Property Controlling in Section | S _____ T _____ R _____ | _____ |
| | S _____ T _____ R _____ | _____ |
| 3. Miscellaneous Property in Sec. | S _____ T _____ R _____ | _____ |
| | S _____ T _____ R _____ | _____ |
| 4. Lot No. _____, Recorded Plat _____ | | |
| 5. Private Claims _____ | | |

Register of Deeds Stamp & File Number

I, Shelby W. Money, in a field survey on September 27, 19 93, do hereby certify that under requirements of P.A. 74, Michigan P.A. of 1970, the corner points mentioned in lines 1 and 2 above were in conformance with regulations and rules therefore as required in the current manual of survey instructions of the United States Department of the Interior, Bureau of Land Management or by a decree of a Court of Law and/or that the corner points mentioned in lines 3, 4 and 5 above were in conformance with the rules of the Michigan Board of Land Surveyors or by a Decree of a Court of Law; established, re-established, monumented, re-monumented, recovered, found as expressed below:

NOTE: Not more than 4 corners, all in the same town and range, may be recorded on this certificate.

	A	B	C	D	E	F	G	H	I	J	K	L	M
2	6	5	4	3	2								
3													
4	7	8	9	10	11	12							
5													
6	18	17	16	15	14	13							
7													
8	19	20	21	22	23	24							
9													
10	30	29	28	27	26	25							
11													
12	31	32	33	34	35	36							
13													

A. Description of original monument and accessories and/or subsequent restoration:

- Post G.L.O. notes page 378
- 1/2" Iron set by Swarts (1974) L.2 P.701
- 1/2" Iron by Kobs (1991) L.4 P.384


B. Description of corner evidence found and/or method applied in restoring or reestablishing corner:

- Found 1/2" Rebar 6" deep
- Witnessess found:
 - Point of large rock ESE 30.0'
 - Pk nail in 5" Elm NE 90.52'
 - Nail w/ cap GTE Post SE 44.23'
 - Pk nail in corner of fence post SW 31.90'

C. Description of monument for corner and accessories established to perpetuate locating the position of the corner:

- Set Lapeer tag/nail in west face of utility pole N 20° W 141.20'
- Set Lapeer tag/nail in west face of utility pole N 30° E 139.20'
- Set Lapeer tag/nail in southeast face of a 5" Elm N 25° E 90.50'
- Point of large rock S 80° E 30.00'
- Set Lapeer tag/nail and cap in General Telephone Post S 35° E 44.25'
- Set Lapeer tag/nail in northwest face of utility pole S 60° W 73.30'

SET LAPEER COUNTY REMONUMENTATION BRASS CAP MARKED 30092 / M-11 OVER EXISTING IRON

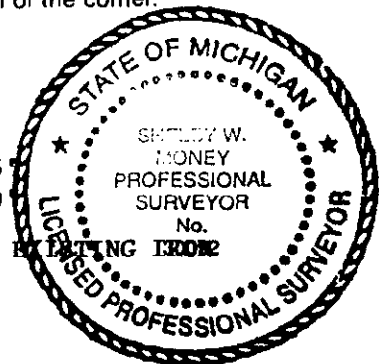

Signed by *Shelby W. Money* Date December 21, 1993
Surveyor's Michigan License No. 30092