

SURVEY &
REMONUMENTATION

1993

COMMISSION

REMONUMENTATION
LAND CORNER RECORDATION CERTIFICATE
Filing Requirement of Act 74, Mich. P.A. 1970

RECEIVED FOR RECORD

93 DEC 22 PM 2:38

LIBER IN 5 PAGE NO. 3

Melissa Miles
REGISTERED SURVEYOR
LAPEER COUNTY, MICHIGAN

For corners in

LAPEER
(County)

Located In: Corner Code ##
Attica Township

- | | | |
|---------------------------------------|--------------------------|-------------|
| 1. Public Land Survey | T <u>7N</u> R <u>11E</u> | <u>M-12</u> |
| | T _____ R _____ | _____ |
| | T _____ R _____ | _____ |
| | T _____ R _____ | _____ |
| 2. Property Controlling in Section | S _____ T _____ R _____ | _____ |
| | S _____ T _____ R _____ | _____ |
| 3. Miscellaneous Property in Sec. | S _____ T _____ R _____ | _____ |
| | S _____ T _____ R _____ | _____ |
| 4. Lot No. _____, Recorded Plat _____ | | |
| 5. Private Claims _____ | | |

Register of Deeds Stamp & File Number

	A	B	C	D	E	F	G	H	I	J	K	L	M
2	6	5	4	3	2	1							
3													
4	7	8	9	10	11	12							
5													
6	18	17	16	15	14	13							
7													
8	19	20	21	22	23	24							
9													
10	30	29	28	27	26	25							
11													
12	31	32	33	34	35	36							
13													

I, Shelby W. Money, in a field survey on September 27, 19 93, do hereby certify that under requirements of P.A. 74, Michigan P.A. of 1970, the corner points mentioned in lines 1 and 2 above were in conformance with regulations and rules therefore as required in the current manual of survey instructions of the United States Department of the Interior, Bureau of Land Management or by a decree of a Court of Law and/or that the corner points mentioned in lines 3, 4 and 5 above were in conformance with the rules of the Michigan Board of Land Surveyors or by a Decree of a Court of Law; established, re-established, monumented, re-monumented, recovered, found as expressed below:

NOTE: Not more than 4 corners, all in the same town and range, may be recorded on this certificate.

A. Description of original monument and accessories and/or subsequent restoration:

- Post G.L.O. notes page 378
- L.C.R.C. L.2 P.701 by Swarts (1974) 1/2" Iron
- L.C.R.C. L.3 P.449 by Henderson (1978) 1/2" Iron
- L.C.R.C. L.4 P.384 by Kobs (1991) 1/2" Iron


B. Description of corner evidence found and/or method applied in restoring or reestablishing corner:

- Found 1/2" Rebar 4" deep
- Found witnesses:
- Northwest 43'+ point of 3" angle iron in concrete curb
- Northeast 46.56' 1/2" Rebar with cap #23510
- East 75.1± a pk in utility pole

C. Description of monument for corner and accessories established to perpetuate locating the position of the corner:

- Set Lapeer tag/nail in southeast face of utility pole N 70° W 30.70'
- Point of 3" Angle iron in concrete curb N 20° W 43.50'
- Southeast corner of building N 70° W 125.90'
- Set Lapeer tag/nail in face of utility pole East 75.15'
- 1/2" Rebar with cap #23510 N 45° E 46.56'

SET LAPEER COUNTY REMONUMENTATION BRASS CAP MARKED 30092 / M-12 OVER EXISTING SURVEYOR

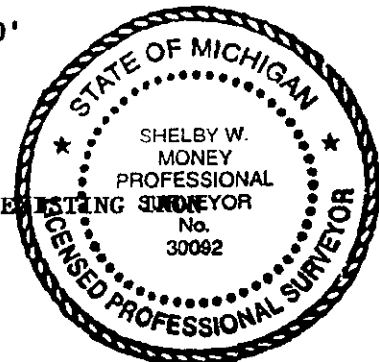

Signed by *Shelby W. Money* Date December 21, 1993
Surveyor's Michigan License No. 30092