

**SURVEY &
REMONUMENTATION**

APR 28 1995

COMMISSION

LAND CORNER RECORDATION CERTIFICATE
Filing Requirement of Act 74, Mich. P.A. 1970

For corners in

<u>LAPEER</u> (County)	Located In: IMLAY TOWNSHIP	Corner Code # _____
1. Public Land Survey	T <u>7N</u> R <u>12E</u>	A-9 _____
	T _____ R _____	_____
	T _____ R _____	_____
	T _____ R _____	_____
2. Property Controlling in Section	S _____ T _____ R _____	_____
	S _____ T _____ R _____	_____
3. Miscellaneous Property in Sec.	S _____ T _____ R _____	_____
	S _____ T _____ R _____	_____

RECEIVED FOR RECORD
94 DEC -9 PM 3:17
LIBER NO. 65 PAGE NO. 143
Nelson De Vaux
REGISTER OF DEEDS
LAPEER COUNTY, MICHIGAN

Register of Deeds Stamp & File Number

4. Lot No. _____, Recorded Plat _____
5. Private Claims _____

I, SHELBY W. MONEY, in a field survey on SEPTEMBER 2, 1994
do hereby certify that under requirements of P.A. 74, Michigan P.A. of 1970, the corner points mentioned in lines 1 and 2 above were in conformance with regulations and rules therefore as required in the current manual of survey instructions of the United States Department of the Interior, Bureau of Land Management or by a decree of a Court of Law and /or that the corner points mentioned in lines 3, 4 and 5 above were in conformance with the rules of the Michigan Board of Land Surveyors or by a Decree of a Court of Law, established, re-established, monumented, re-monumented, recovered, found as expressed below:

NOTE: Not more than 4 corners, all in the same town and range, may be recorded on this certificate.

A	B	C	D	E	F	G	H	I	J	K	L	M
1												
2	6	5	4	3	2	1						
3												
4	7	8	9	10	11	12						
5												
6	10	17	16	15	14	13						
7												
8	19	20	21	22	23	24						
9												
10	30	29	28	27	26	25						
11												
12	31	32	33	34	35	36						
13												

A. Description of original monument and accessories and/or subsequent restoration:

G.L.O.	1824	PAGE 590	LUCIUS LYON	SET POST NO WITNESSES SET
ROAD PLAN	1919	PART OF COUNTY ROAD #68 / NEWARK ROAD		FOUND, 47 LINKS NORTH OF M-9, T.7N., R.11E.
WITNESS	1973	UNRECORDED	LAPEER CTY ROAD COMMISSION	FOUND, UNKNOWN
LCRC	1977	LIBER 003 PAGE 275	DOUGLAS W. HOOTH, #7966	SET, 5/8" ROD WITH 1/2" MDSH CAP #19241


B. Description of corner evidence found and/or method applied in restoring or reestablishing corner:

FOUND, 1 1/2" MDSH BRASS CAP IN MONUMENT BOX
MATCHES OFFSET RECORDED IN LCRC FOR M-9, T.7N., R.11E.
NO WITNESSES FOUND EXCEPT TIE DISTANCE

G.L.O. OFFSET IS 47 LINKS NORTH 31.02'
FOUND M-9, T.7N., R.11E. SOUTH 30.90'

FOUND POINT IS 0.45' EAST OF LINE BETWEEN M-9 AND M-8, T.7N., R.11E.

A-9 TO A-8 T.7N., R.12E. G.L.O. (POST FOR A-8 NEVER SET) CHAINS MEASURED 2634.10'

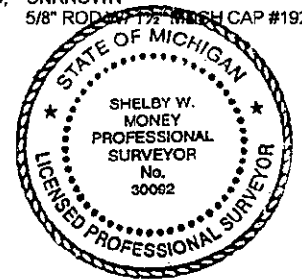

C. Description of monument for corner and accessories established to perpetuate locating the position of the corner:

FOUND, 5/8" ROD WITH BRASS MDSH CAP IN A MONUMENT BOX. LEFT IN PLACE

AZIMUTH	10°	198.57'	SET,	NAIL W/LAPEER COUNTY TAG IN THE WEST FACE OF A UTILITY POLE
AZIMUTH	105°	185.54'	SET,	NAIL W/LAPEER COUNTY TAG IN THE NORTH FACE OF A UTILITY POLE
AZIMUTH	165°	105.48'	FOUND,	DOUBLE HEADED NAIL W/MDSH TAG IN THE SOUTHWEST FACE OF A 20" OAK
AZIMUTH	350°	113.85'	FOUND,	DOUBLE HEADED NAIL W/MDSH TAG IN THE EAST FACE OF A UTILITY POLE
AZIMUTH	180°	30.90'	FOUND,	IRON / M-9, T.7N., R.11E. / ATTICA TOWNSHIP

Signed by *Shelby W. Money* PEER GROUP APPROVED LAND CORNER
PA 345 OF 1994 December 2, 1994
Surveyor's Michigan License No. 30092 LAPEER COUNTY

RAY DAVIS P.S. CO. SURVEYOR
DATE 12-9-94

FORM APPROVED BY MICHIGAN STATE BOARD OF LAND SURVEYORS, JAN. 28, 1971
REVISED MAY 14, 1978
REVISED JAN., 1983

LIBER 0005 PAGE 0143