SURVEY & REMONUMENTATION

APR 2 8 1995

COMMISSION

LAND CORNER RECORDATION CERTIFICATE
Filing Requirement of Act 74, Mich. P.A. 1970

For corners in

Lapeer (County) — Located In: Imlay Township — Corner Code # I-13

1. Public Land Survey — T 7 N R 12 E
2. Property Controlling in Section — S___ T___ R___
3. Miscellaneous Property in Sec. — S___ T___ R___

RECEIVED FOR RECORD
94 DEC 29 AM 10: 25
LIBER NO. 25 PAGE NO. 199
REGISTER OF DEEDS
LAPEER COUNTY, MICHIGAN

Register of Deeds Stamp & File Number

4. Lot No. _____, Recorded Plat _____
5. Private Claims _____

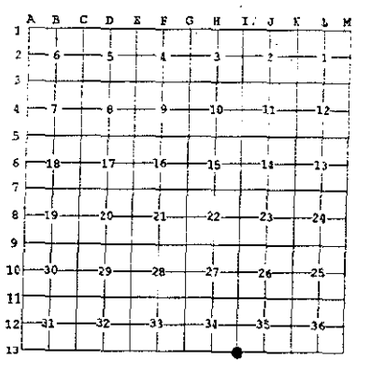

I, Shelby W. Money, in a field survey on 11-18, 19 94 do hereby certify that under requirements of P.A. 74, Michigan P.A. of 1970, the corner points mentioned in lines 1 and 2 above were in conformance with regulations and rules therefore as required in the current manual of survey instructions of the United States Department of the Interior, Bureau of Land Management or by a decree of a Court of Law and /or that the corner points mentioned in lines 3, 4 and 5 above were in conformance with the rules of the Michigan Board of Land Surveyors or by a Decree of a Court of Law; established, re-established, monumented, re-monumented, recovered, found as expressed below:

NOTE: Not more that 4 corners, all in the same town and range, may be recorded on this certificate.

A. Description of original monument and accessories and/or subsequent restoration:

1. *Joseph Wampler, D.S. 1822 pages 556-560 Set post No witnesses found*
2. Gilbert Bates 1865 pages 348-349 Stone 20" - 9" - 6"
3. Recorded survey by Earl Gravlin, P.S. # 23510 on 1-10-80 in liber 5, page 580 as a found flagged nail at base of corner post.
4. Unrecorded survey by Charles Getz, P.S. # 25843 on 11-17-82 as a flagged nail at base of corner post.

B. *Description of corner evidence found and/or method applied in restoring or reestablishing corner:*

Found a rotted off post in remains of fences running North, East and West. In wooded area North side of Drain.

Found witnesses from items 3 and 4 above:
N 35° W 53.90' Nail in 60" Maple *Found large stump at this location.*
S 50° W 15.13' Nail in 16" Poplar.
S 70° W 27.30' Nail in 8" poplar.

Distances: East to J-13 Imlay Township 2620.08'
West to I-1 Almont Township 457.59'.
West to H-13 Imlay Township 2614.33" (Gilbert Bates 2629.44').

C. Description of monument for corner and accessories established to perpetuate locating the position of the corner:

Placed standard Lapeer County Remonumentation cap stamped "I-13 30092" on 18" rebar at remains of corner fence post.

Witnesses:
Az 5° 9.32' Chilsed "X" on top of pointed rock
Az 155° 20.75' Set PK with Lapeer County tag in North face of 12" Maple
Az 240° 13.60' Set PK with Lapeer County tag in East face of 24" Poplar
Az 345° 54.20' Set PK with Lapeer County tag in East face of 14" Elm

PEER GROUP
APPROVED LAND CORNER
PA 345 OF 1990
LAPEER COUNTY
RAY DAVIS P.S. CO. SURVEYOR
DATE 12-28-94

Signed by Shelby W. Money 12/22/94
Surveyor's Michigan License No. 30092

STATE OF MICHIGAN — SHELBY W. MONEY PROFESSIONAL SURVEYOR No. 30092 — LICENSED PROFESSIONAL SURVEYOR

FORM APPROVED BY MICHIGAN STATE BOARD OF LAND SURVEYORS, JAN. 28, 1971
REVISED MAY 14, 1975
REVISED JAN., 1983

LIBER 0005 PAGE 0199