

SURVEY & REMONUMENTATION

APR 29 1996

COMMISSION

LAND CORNER RECORDATION CERTIFICATE

Filing Requirement of Act 74, Mich. P.A. 1970

RECEIVED FOR RECORD

For corners in
LAPEER

(County)

Located in:
IMLAY TOWNSHIP

Corner Code #

95 DEC 28 PM 2:35

LIBER NO. 005 PAGE NO. 322

Melissa DeVough

REGISTER OF DEEDS
LAPEER COUNTY MICHIGAN

Register of Deeds Stamp & File Number

1. Public Land Survey	T	<u>7N</u>	R	<u>12E</u>	<u>M-1</u>
	T		R		
	T		R		
	T		R		
2. Property Controlling in Section	S		T	R	
	S		T	R	
3. Miscellaneous Property in Section	S		T	R	
	S		T	R	

4. Lot No. _____, Recorded Plat _____
5. Private Claims _____

	A	B	C	D	E	F	G	H	I	J	K	L
2	6		5		4		3		2		1	
3												
4	7		8		9		10		11		12	
5												
6	18		17		16		15		14		13	
7												
8	19		20		21		22		23		24	
9												
10	30		29		28		27		26		25	
11												
12	31		32		33		34		35		36	
13												

I, James T. Bailey, in a field survey on November 6, 1995, do hereby certify that under requirements of P.A. 74, Michigan P.A. of 1970, the corner points mentioned in lines 1 and 2 above were in conformance with regulations and rules therefore as required in the current manual of survey instructions of the United States Department of the Interior, Bureau of Land Management or by a decree of a Court of Law and/or that the corner points mentioned in lines 3, 4 and 5 above were in conformance with the rules of the Michigan Board of Professional Surveyors or by a Decree of a Court of Law; established, re-established, monumented, re-monumented, recovered, found as expressed below:

NOTE: Not more than 4 corners, all in the same town and range, may be recorded on this certificate.

A. Description of original monument and accessories and/or subsequent restoration:

- G.L.O. (1822) WAMPLER D.S. SET POST NO WITNESSES SET (SWAMP)
- SURVEY (7/16/87) GRAVLIN P.S. L.7 P.741 FOUND 3/4" PIPE NO WITNESSES STATED
- L.C.R.C. (1/5/95) NIEDERHAUSER P.S. L.5 P.79 RECORDED AS M-13 T8N-R12E

B. Description of corner evidence found and/or method applied in restoring or reestablishing corner:

1995 JAMES T. BAILEY P.S. FOUND LAPEER COUNTY REMONUMENTATION CAP #24608. EXISTING CORNER MATCHES DISTANCES FOR SURVEY IN ITEM #2 ABOVE.

DISTANCES
M-2 2339.83
L-1 2632.31


PEER GROUP
APPROVED LAND CORNER
PA 345 OF 1990
LAPEER COUNTY

Ray Davis
RAY DAVIS P.S. CO. SURVEYOR
DATE 8-31-95

C. Description of monument for corner and accessories established to perpetuate locating the position of the corner:

M-1 ACCEPTED EXISTING REMON AS CORNER COMMON TO M-1 T7N-R12E AND M-13 T8N-R12E.

WITNESSES AS RECORDED IN L.5 P.79
SW TO PK NAIL IN NW SIDE MULTI-STEM ELM 163.44
NW TO NAIL IN S SIDE P. POLE 127.40
NE TO NAIL S SIDE P. POLE 65.16
SE TO CAPPED IRON #18986 47.10

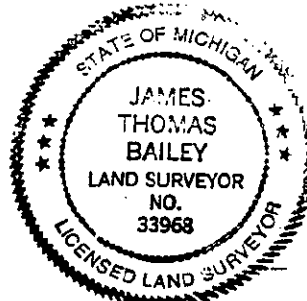

Signed by *JT Bailey* Date DECEMBER 20, 1995
Surveyor's Michigan License No. 33968

APPROVED BY MICHIGAN STATE BOARD OF PROFESSIONAL SURVEYORS, JAN. 28, 1971
REVISED MAY 14, 1975
REVISED JAN., 1983