

SURVEY & REMONUMENTATION

APR 29 1996

COMMISSION LAND CORNER RECORDATION CERTIFICATE Filing Requirement of Act 74, Mich. P.A. 1970

For corners in LAPEER (County) Located In: IMLAY TOWNSHIP Corner Code # M-2

1. Public Land Survey	T	<u>7N</u>	R	<u>12E</u>	<u>M-2</u>
	T	_____	R	_____	_____
	T	_____	R	_____	_____
	T	_____	R	_____	_____
2. Property Controlling in Section	S	_____	T	_____	_____
	S	_____	T	_____	_____
3. Miscellaneous Property in Section	S	_____	T	_____	_____
	S	_____	T	_____	_____

4. Lot No. _____, Recorded Plat _____

5. Private Claims _____

RECEIVED FOR RECORD
95 DEC 28 PM 2:36
LIBER NO. 005 PAGE NO. 323
Melissa De Vough
REGISTER OF DEEDS
LAPEER COUNTY MICHIGAN

Register of Deeds Stamp & File Number

	A	B	C	D	E	F	G	H	I	J	K	L	M
2	6	5	4	3	2	1							
3													
4	7	8	9	10	11	12							
5													
6	18	17	16	15	14	13							
7													
8	19	20	21	22	23	24							
9													
10	30	29	28	27	26	25							
11													
12	31	32	33	34	35	36							

I, James T. Bailey, in a field survey on November 6, 1995, do hereby certify that under requirements of P.A. 74, Michigan P.A. of 1970, the corner points mentioned in lines 1 and 2 above were in conformance with regulations and rules therefore as required in the current manual of survey instructions of the United States Department of the Interior, Bureau of Land Management or by a decree of a Court of Law and/or that the corner points mentioned in lines 3, 4 and 5 above were in conformance with the rules of the Michigan Board of Professional Surveyors or by a Decree of a Court of Law; established, re-established, monumented, re-monumented, recovered, found as expressed below:

NOTE: Not more than 4 corners, all in the same town and range, may be recorded on this certificate.

A. Description of original monument and accessories and/or subsequent restoration:

1. G.L.O. (1822) WAMPLER D.S. SET POST NO WITNESSES FOUND
2. L.C.R.C. GRAVLIN P.S. L.4 P.140 FOUND 1/2" IRON
3. SURVEY GRAVLIN P.S. L.7 P.741 FOUND 1/2" IRON
4. LAPEER COUNTY ROAD COMMISSION FOUND 1/2" IRON

B. Description of corner evidence found and/or method applied in restoring or reestablishing corner:

1995 JAMES T. BAILEY P.S. FOUND 1/2" IRON ROD 4" BELOW GRADE IN THE CENTERLINE OF CADE ROAD (GRAVEL). REMAINING WITNESSES FROM ITEMS 2 AND 3 ABOVE MATCH.


DISTANCES
M-1 2339.83
M-3 2595.75

PEER GROUP
APPROVED LAND CORNER
PA 345 OF 1990
LAPEER COUNTY
[Signature]
RAY DAVIS P.S. CO. SURVEYOR
DATE 7-13-95

C. Description of monument for corner and accessories established to perpetuate locating the position of the corner:

M-2 SET STANDARD LAPEER COUNTY REMONUMENTATION CAP ON FOUND 1/2" ROD.

S.85°W. 36.11 SET PK NAIL W/ REMON TAG IN 10" BOX ELDER
S.15°W. 113.91 SET PK NAIL W/ REMON TAG IN 12" POPLAR
S.25°E. 54.09 SET PK NAIL W/ REMON TAG IN 21" MAPLE
N.75°E. 31.31 SET PK NAIL W/ REMON TAG IN TWIN 10" MAPLE

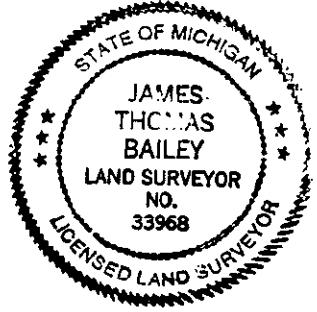

Signed by [Signature] Date DECEMBER 19, 1995
Surveyor's Michigan License No. 33968