

SURVEY & REMONUMENTATION

APR 29 1995

COMMISSION

LAND CORNER RECORDATION CERTIFICATE

Filing Requirement of Act 74, Mich. P.A. 1970

RECEIVED FOR RECORD

For corners in

LAPEER
(County)

Located In:
IMLAY TOWNSHIP

Corner Code #

- | | | | | | |
|------------------------------------|---|-----------|---|------------|------------|
| 1. Public Land Survey | T | <u>7N</u> | R | <u>12E</u> | <u>M-3</u> |
| | T | | R | | |
| | T | | R | | |
| | T | | R | | |
| 2. Property Controlling in Section | S | | T | R | |
| | S | | T | R | |
| 3. Miscellaneous | S | | T | R | |
| Property in Section | S | | T | R | |

95 DEC 28 PM 2:37
LIBER NO. 005 PAGE NO. 324
Melissa DaVough
REGISTER OF DEEDS
LAPEER COUNTY MICHIGAN

Register of Deeds Stamp & File Number

4. Lot No. _____, Recorded Plat _____
5. Private Claims _____

A	B	C	D	E	F	G	H	I	J	K	L	M
2	6	5	4	3	2	1						
3												
4	7	8	9	10	11	12						
5												
6	18	17	16	15	14	13						
7												
8	19	20	21	22	23	24						
9												
10	30	29	28	27	26	25						
11												
12	31	32	33	34	35	36						
13												

I, James T. Bailey, in a field survey on November 6, 1995, do hereby certify that under requirements of P.A. 74, Michigan P.A. of 1970, the corner points mentioned in lines 1 and 2 above were in conformance with regulations and rules therefore as required in the current manual of survey instructions of the United States Department of the Interior, Bureau of Land Management or by a decree of a Court of Law and/or that the corner points mentioned in lines 3, 4 and 5 above were in conformance with the rules of the Michigan Board of Professional Surveyors or by a Decree of a Court of Law; established, re-established, monumented, re-monumented, recovered, found as expressed below:

NOTE: Not more than 4 corners, all in the same town and range, may be recorded on this certificate.

A. Description of original monument and accessories and/or subsequent restoration:

- G.L.O. (1822) WAMPLER D.S. SET POST NO WITNESSES FOUND
- L.C.R.C. GRAVLIN P.S. L.4 P.140 SET 1/2" IRON
- SURVEY BAILEY P.S. L.10 P.812 FOUND 1/2" IRON
- LAPEER COUNTY ROAD COMMISSION FOUND 1/2" IRON

B. Description of corner evidence found and/or method applied in restoring or reestablishing corner:

1995 JAMES T. BAILEY P.S. FOUND 1/2" IRON 1' WEST OF CENTERLINE OF CADE ROAD (GRAVEL) 46' SOUTH OF THE CENTERLINE OF THE SOUTH BRANCH OF MILL DRAIN. REMAINING WITNESSES FROM ITEMS #2 AND #3 ABOVE MATCH.

DISTANCES

M-2 2595.75
M-4 2678.68


PEER GROUP
APPROVED LAND CORNER
PA 343 OF 1990
LAPEER COUNTY

James T. Bailey
JAMES T. BAILEY P.S. CO. SURVEYOR
DATE 7-13-95

C. Description of monument for corner and accessories established to perpetuate locating the position of the corner:

M-3 SET STANDARD LAPEER COUNTY REMONUMENTATION CAP ON FOUND 1/2" IRON.

- N.30°W. 27.26 SET PK NAIL W/ REMON TAG IN GUARD RAIL POST
- N.30°E. 26.24 SET PK NAIL W/ REMON TAG IN GUARD RAIL POST
- N.87°W. 72.83 SET PK NAIL W/ REMON TAG IN WOODEN POST
- N.18°E. 82.33 SET PK NAIL W/ REMON TAG IN 8"x8" FENCE POST

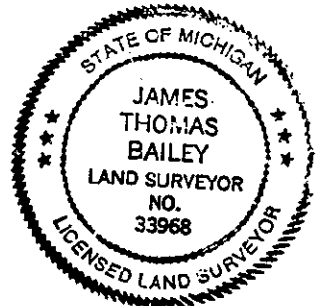

Signed by *J. Bailey* Date DECEMBER 19, 1995

Surveyor's Michigan License No. 33968

FORM APPROVED BY MICHIGAN STATE BOARD OF PROFESSIONAL SURVEYORS, JAN. 28, 1971
REVISED MAY 14, 1975
REVISED JAN., 1983