

RECORDED

1993

BOOK

REMONUMENTATION  
LAND CORNER RECORDATION CERTIFICATE  
Filing Requirement of Act 74, Mich. P.A. 1970

RECEIVED FOR RECORD

94 JAN -5 PM 1:30

LIBER NO. 005 P. NO. 80  
*Melina Miles*  
REGISTERED LAND SURVEYOR

For corners in

_____ (County)	Located In:	Corner Code #
	Imlay Twp.	
1. Public Land Survey	T <u>7N</u> R <u>12E</u>	<u>M-10</u>
	T _____ R _____	_____
	T _____ R _____	_____
	T _____ R _____	_____
2. Property Controlling in Section	S _____ T _____ R _____	_____
	S _____ T _____ R _____	_____
3. Miscellaneous Property in Sec.	S _____ T _____ R _____	_____
	S _____ T _____ R _____	_____
4. Lot No. _____, Recorded Plat _____		
5. Private Claims _____		

Register of Deeds Stamp & File Number

	A	B	C	D	E	F	G	H	I	J	K	L	M
2	6	5	4	3	2	1							
3													
4	7	8	9	10	11	12							
5													
6	18	17	16	15	14	13							
7													
8	19	20	21	22	23	24							
9													
10	30	29	28	27	26	25							
11													
12	31	32	33	34	35	36							
13													


John C. Niederhauser, in a field survey on Nov. 4, 1993, do hereby certify that under requirements of P.A. 74, Michigan P.A. of 1970, the corner points mentioned in lines 1 and 2 above were in conformance with regulations and rules therefore as required in the current manual of survey instructions of the United States Department of the Interior, Bureau of Land Management or by a decree of a Court of Law and/or that the corner points mentioned in lines 3, 4 and 5 above were in conformance with the rules of the Michigan Board of Land Surveyors or by a Decree of a Court of Law; established, re-established, monumented, re-monumented, recovered, found as expressed below:

**NOTE: Not more than 4 corners, all in the same town and range, may be recorded on this certificate.**

A. Description of original monument and accessories and/or subsequent restoration:  
Post (G.L.O. Notes, pg. 560) No bearing trees  
Set post at 40 ch north of corner common to Sections 25 & 36

B. Description of corner evidence found and/or method applied in restoring or reestablishing corner:  
Capped iron #18986  
Set on even split between NE Corner Section 25 & SE Corner Section 25  
2632.10' North to NE corner Section 25  
2632.10' South to SE corner Section 25

C. Description of monument for corner and accessories established to perpetuate locating the position of the corner:  
Set brass disk stamped "Lapeer County Remonumentation M-10 #24608  
E to nail w/tag N side 4" poplar 22.06'  
N to nail w/tag E side 12" oak 25.74'  
W to nail w/tag N side 8" oak 31.62'  
WSW to nail w/tag N side 10" poplar 41.38' (found by me)

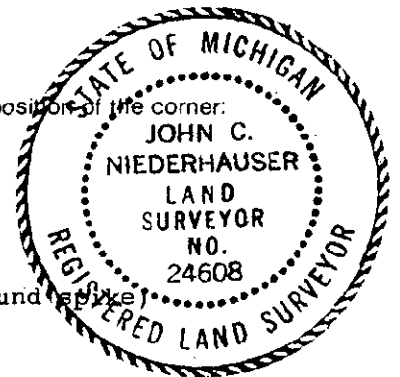

Signed by *John C. Niederhauser* Date Dec. 30, 1993  
Surveyor's Michigan License No. 24608

LIBER 005 P. NO. 80