

SURVEY & REMONUMENTATION

1993

COMMISSION

**REMONUMENTATION
LAND CORNER RECORDATION CERTIFICATE
Filing Requirement of Act 74, Mich. P.A. 1970**

For corners in

Lapeer
(County)

Located In: Imlay Twp.
Corner Code #

- | | | | | | |
|---------------------------------------|---|----|---|-----|------|
| 1. Public Land Survey | T | 7N | R | 12E | M-11 |
| | T | | R | | |
| | T | | R | | |
| | T | | R | | |
| 2. Property Controlling in Section | S | | T | R | |
| | S | | T | R | |
| 3. Miscellaneous Property in Sec. | S | | T | R | |
| | S | | T | R | |
| 4. Lot No. _____, Recorded Plat _____ | | | | | |
| 5. Private Claims _____ | | | | | |

RECEIVED FOR RECORD

94 JAN -5 PM 1:32

LIBER NO. 005 PAGE NO. 81

Melissa Miles
REGISTERED DEEDS
LAPPEER COUNTY MICHIGAN

Register of Deeds Stamp & File Number

	A	B	C	D	E	F	G	H	I	J	K	L	M
2	6		5		4		3		2		1		
3													
4	7		8		9		10		11		12		
5													
6	18		17		16		15		14		13		
7													
8	19		20		21		22		23		24		
9													
10	30		29		28		27		26		25		
11													
12	31		32		33		34		35		36		
13													

I, John C. Niederhauser, in a field survey on Nov. 4, 19 93, do hereby certify that under requirements of P.A. 74, Michigan P.A. of 1970, the corner points mentioned in lines 1 and 2 above were in conformance with regulations and rules therefore as required in the current manual of survey instructions of the United States Department of the Interior, Bureau of Land Management or by a decree of a Court of Law and/or that the corner points mentioned in lines 3, 4 and 5 above were in conformance with the rules of the Michigan Board of Land Surveyors or by a Decree of a Court of Law; established, re-established, monumented, re-monumented, recovered, found as expressed below:

NOTE: Not more than 4 corners, all in the same town and range, may be recorded on this certificate.

A. Description of original monument and accessories and/or subsequent restoration:


Post (G.L.O. Notes, pg. 560) No bearing trees
40 ch North to E 1/4 post Section 25

B. Description of corner evidence found and/or method applied in restoring or reestablishing corner:

T-iron in Mon. box
2660.14' South to E 1/4 corner section 36

C. Description of monument for corner and accessories established to perpetuate locating the position of the corner:

- Set brass disk stamped "Lapeer County Remonumentation M-11 #24608
- SSE to nail w/tag top of guard post 18.40'
- SE to nail w/tag W side P. pole 67.08' (found MSPH nail w. tag)
- WSW to nail w/tag N side P. pole 120.08'
- NE to nail w/tag top of 10" gate post 50.54'
- S to state Hwy R.O.W. marker #3-77024 33.18'

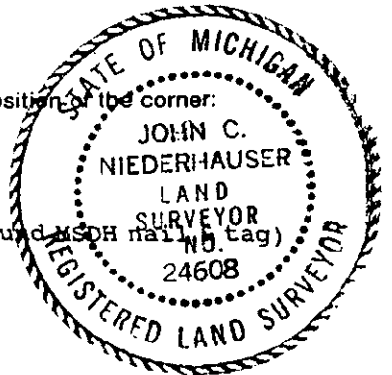

Signed by [Signature]
Surveyor's Michigan License No. 24608

Date Dec. 30, 1993