

1993

COMMISSION

REMONUMENTATION LAND CORNER RECORDATION CERTIFICATE

Filing Requirement of Act 74, Mich. P.A. 1970

RECEIVED FOR RECORD

For corners in

Lapeer (County)

Located In: Imlay Twp.

Corner Code #

- 1. Public Land Survey T 7N R 12E M-12
2. Property Controlling in Section S T R
3. Miscellaneous Property in Sec. S T R
4. Lot No. , Recorded Plat
5. Private Claims

94 JAN -5 PM 1:33 LIBER NO 005 PAGE NO 82 Melissa Miles REGISTERED LAND SURVEYOR LAPEER COUNTY MICHIGAN

Register of Deeds Stamp & File Number

John C. Niederhauser, in a field survey on Nov. 4, 1993, do hereby certify that under requirements of P.A. 74, Michigan P.A. of 1970, the corner points mentioned in lines 1 and 2 above were in conformance with regulations and rules therefore as required in the current manual of survey instructions of the United States Department of the Interior, Bureau of Land Management or by a decree of a Court of Law and/or that the corner points mentioned in lines 3, 4 and 5 above were in conformance with the rules of the Michigan Board of Land Surveyors or by a Decree of a Court of Law; established, re-established, monumented, re-monumented, recovered, found as expressed below:

NOTE: Not more than 4 corners, all in the same town and range, may be recorded on this certificate.

Grid table with columns A-M and rows 2-13. Cell 12,36 contains a black dot.

A. Description of original monument and accessories and/or subsequent restoration:


Post (G.L.O. Notes, pg. 560) Elm 11" N 39°W 31 W.O. 36" S 7°W 38

B. Description of corner evidence found and/or method applied in restoring or reestablishing corner:

Found boat spike W to nail w/washer in fence post 35.24' SE to P.K. nail in NE face P. pole 53.42' 2660.14' North to NE corner Section 36 2644.38' South to SE corner Section 36

C. Description of monument for corner and accessories established to perpetuate locating the position of the corner:

Set brass disk stamped "Lapeer County Remonumentation M-12 #24608" SW to nail w/tag NW face 10" elm 67.72' NE to base of stop sign 34.54' SE to nail w/tag in west side fence post 34.10' W to nail w/tag in fence post 35.24'

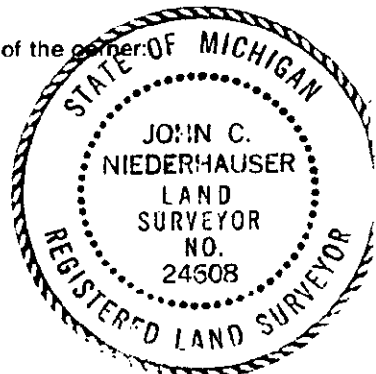

Signed by [Signature] Date Dec. 30, 1993

Surveyor's Michigan License No. 24608