

SURVEY &
REMONUMENTATION

MAR 23 2000

SECTION

REMONUMENTATION

LAND CORNER RECORDATION CERTIFICATE

Filing Requirement of Act 74, Mich. P.A. 1970

RECEIVED FOR RECORD

00 FEB 10 PM 2:16


For corners in

LAPEER Located In: OREGON TWP. Corner Code # _____
(County)

1. Public Land Survey T 8 N R 9 E B-13
T _____ R _____
T _____ R _____
T _____ R _____

2. Property Controlling S _____ T _____ R _____
in Section S _____ T _____ R _____

3. Miscellaneous S _____ T _____ R _____
Property in Sec. S _____ T _____ R _____

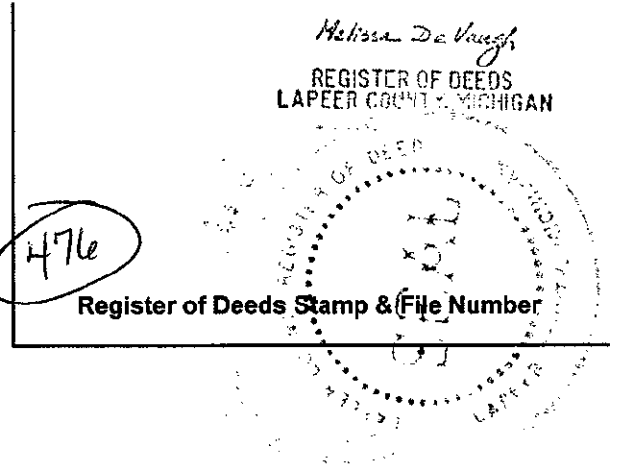

4. Lot No. _____, Recorded Plat _____
5. Private Claims _____

	A	B	C	D	E	F	G	H	I	J	K	L	M
1													
2	6	5	4	3	2	1							
3													
4	7	8	9	10	11	12							
5													
6	18	17	16	15	14	13							
7													
8	19	20	21	22	23	24							
9													
10	30	29	28	27	26	25							
11													
12	31	32	33	34	35	36							
13													

I, MICHAEL G. HAY, in a field survey on AUGUST 22 1999, do hereby certify that under requirements of P.A. 74, Michigan P.A. of 1970, the corner points mentioned in lines 1 and 2 above were in conformance with regulations and rules therefore as required in the current manual of survey instructions of the United States Department of the Interior, Bureau of Land Management or by a decree of a Court of Law and/or that the corner points mentioned in lines 3, 4 and 5 above were in conformance with the rules of the Michigan Board of Land Surveyors or by a Decree of a Court of Law; established, re-established, monumented, re-monumented, recovered, found as expressed below:

NOTE: Not more than 4 corners, all in the same town and range, may be recorded on this certificate.

A. Description of original monument and accessories and/or subsequent restoration:
 1822- JOSEPH WAMPLER D.S. SET 1/2 MILE POST
 1866- GILBERT BATES C.S. 32 12 12 SMALL STONES
 1974- HAROLD N. ELRICH P.S. 18986 (SURVEY) LIBER 2 PAGE 846 FOUND 1/2" IRON
 1978- DONALD G. RICHARDS P.S. 24614 (UNRECORDED) FOUND P.K. NAIL
 1985- HAROLD N. ELRICH P.S. 18986 (SURVEY) LIBER 7 PAGE 37 FOUND P.K. NAIL
 1997-EARL E. GRAVLIN P.S. 23510 (SURVEY) LIBER 12 PAGE 207 FOUND IRON IN MON BOX
 1997-RAY D. DAVIS P.S. 22430 (UNRECORDED) FOUND 1/2" IRON IN MON BOX
 1997-CHARLE LILLIEBERG P.S. 40162 (UNRECORDED) FOUND 3/8" IRON IN MONUMENT BOX

PEER GROUP
 APPROVED LAND CORNER
 PA 345 OF 1990
 LAPEER COUNTY
 RAY DAVIS P.S. CO. SURVEYOR
 12-2-1999

B. Description of corner evidence found and/or method applied in restoring or reestablishing corner:
 1999-MICHAEL G. HAY P.S. 41101 FOUND 1/2" IRON IN MON BOX, 6.8' NORTH OF CENTER LINE ON OREGON. TREE LINE RUNNING NORTH.

B-13 TO C-13 2626.44' (M) 2626.31' (GRAVLIN) 2640.00' (40 GLO)
 B-13 TO A-13 2127.01' (M) 2126.83' (HBE) 2475.00' (37.50 GLO)
 B-13 TO B-1 EAST 113.81' (M) 113.84' (R&M)

C. Description of monument for corner and accessories established to perpetuate locating the position of the corner:
 SET STANDARD REMONUMENTATION CAP ON 1/2" IRON IN MONUMENT BOX.
 S 50 E 60.65' TAG 40162 IN NORTH FACE OF 8" WILLOW
 NORTH 31.59' TAG 40162 IN WEST FACE OF 14" ELM
 EAST 113.84' NORTH 1/4 CORNER, T7N-R9E
 N 70 W 92.97' MAG NAIL IN SOUTH FACE OF POWER POLE



Signed by Michael G. Hay Date 1-11-2000
 Surveyor's Michigan License No. 41101