

**SURVEY & REMONUMENTATION**

MAR 23 2000

**REMONUMENTATION**

RECEIVED FOR RECORD

**SECTION LAND CORNER RECORDATION CERTIFICATE**

00 FEB 10 PM 2:17

Filing Requirement of Act 74, Mich. P.A. 1970

For corners in

*Melissa De Vaughn*  
REGISTER OF DEEDS  
LAPEER COUNTY, MICHIGAN


LAPEER Located In: OREGON TWP Corner Code # \_\_\_\_\_  
(County)

1. Public Land Survey T 8 N R 9 E D-13  
T \_\_\_\_\_ R \_\_\_\_\_  
T \_\_\_\_\_ R \_\_\_\_\_  
T \_\_\_\_\_ R \_\_\_\_\_

2. Property Controlling S \_\_\_\_\_ T \_\_\_\_\_ R \_\_\_\_\_  
in Section S \_\_\_\_\_ T \_\_\_\_\_ R \_\_\_\_\_

3. Miscellaneous S \_\_\_\_\_ T \_\_\_\_\_ R \_\_\_\_\_  
Property in Sec. S \_\_\_\_\_ T \_\_\_\_\_ R \_\_\_\_\_

478

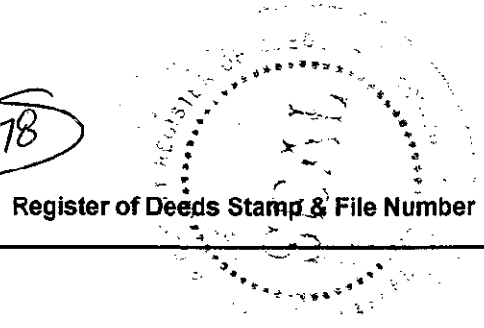

4. Lot No. \_\_\_\_\_, Recorded Plat \_\_\_\_\_  
5. Private Claims \_\_\_\_\_

	A	B	C	D	E	F	G	H	I	J	K	L	M
1													
2	6	5	4	3	2	1							
3													
4	7	8	9	10	11	12							
5													
6	18	17	16	15	14	13							
7													
8	19	20	21	22	23	24							
9													
10	30	29	28	27	26	25							
11													
12	31	32	33	34	35	36							
13													

I, MICHAEL G. HAY, in a field survey on AUGUST 22 1999, do hereby certify that under requirements of P.A. 74, Michigan P.A. of 1970, the corner points mentioned in lines 1 and 2 above were in conformance with regulations and rules therefore as required in the current manual of survey instructions of the United States Department of the Interior, Bureau of Land Management or by a decree of a Court of Law and/or that the corner points mentioned in lines 3, 4 and 5 above were in conformance with the rules of the Michigan Board of Land Surveyors or by a Decree of a Court of Law; established, re-established, monumented, re-monumented, recovered, found as expressed below:

**NOTE: Not more than 4 corners, all in the same town and range, may be recorded on this certificate.**

- A. Description of original monument and accessories and/or subsequent restoration:  
 1822- JOSEPH WAMPLER SET 1/2 MILE POST  
 1867- GILBERT BATES STONE 17 9 8 SMALL STONES  
 1975- HAROLD N. ELRICH P.S. 18986 (SURVEY) LIBER 3 PAGE 457 FOUND IRON  
 1980- JAMES A. BECK P.S. 21559 (SURVEY) LIBER 6 PAGE 3-5 FOUND RAILROAD SPIKE  
 1983- BERNARD HENDERSON P.S. 16043 (SURVEY) LIBER 6 PAGE 613  
 1996- HAROLD N. ELRICH P.S. 18986 (SURVEY) LIBER 11 PAGE 488 FOUND 3/4" IRON IN MON BOX  
 1998- MICHAEL G. HAY P.S. 41101 (SURVEY) LIBER 12 PAGE 573 FOUND 5/8" IRON IN MON BOX

- B. Description of corner evidence found and/or method applied in restoring or reestablishing corner:  
 1999 MICHAEL G. HAY P.S. 41101 FOUND 5/8" IRON IN MON BOX, 5' WEST OF CENTER LINE OF MAPLE ROAD RUNNING NORTH AND 1.5' NORTH OF CENTER LINE OF OREGON ROAD.  
 D-13 TO E-13 2639.94' (M) 2640.00' (40 GLO)  
 D-13 TO C-13 2637.98' (M) 2640.00' (40 GLO)  
 D-13 TO D-1 (EAST) 112.31' (R&M)

PEER GROUP  
APPROVED LAND CORNER  
PA 345 OF 1990  
LAPEER COUNTY

RAY DAVIS P.S. CO. SURVEYOR  
DATE 12 2 1999

- C. Description of monument for corner and accessories established to perpetuate locating the position of the corner:  
 SET STANDARD REMONUMENTATION CAP ON 1/2" IRON IN MON BOX  
 S 10 W 73.43' CHISELED NOTCH WEST END 18" CMP  
 EAST 112.31' 1/2" IRON IN MON BOX  
 N 40 W 92.94' P.K. IN NNE FACE OF POWER POLE  
 S 40 E 92.54' P.K. IN SSE FACE OF POWER POLE



Signed by Michael S. Hay Date 1-11-2000

Surveyor's Michigan License No. 41101

FORM APPROVED BY MICHIGAN STATE BOARD OF LAND SURVEYORS, JAN. 28, 1971

REVISED MAY 14, 1975  
REVISED JAN., 1983  
ADAPTED FOR WORD PROCESSING MARCH, 1993