

**SURVEY & REMONUMENTATION**

**REMONUMENTATION**

RECEIVED FOR RECORD

MAR 23 2000

**LAND CORNER RECORDATION CERTIFICATE**

00 FEB 10 PM 2:17

Filing Requirement of Act 74, Mich. P.A. 1970

For corners in **SECTION**


LAPEER Located In: OREGON TWP. Corner Code # \_\_\_\_\_  
 (County)

1. Public Land Survey T 8 N R 9 E F-13  
 T \_\_\_\_\_ R \_\_\_\_\_  
 T \_\_\_\_\_ R \_\_\_\_\_  
 T \_\_\_\_\_ R \_\_\_\_\_

2. Property Controlling S \_\_\_\_\_ T \_\_\_\_\_ R \_\_\_\_\_  
 in Section S \_\_\_\_\_ T \_\_\_\_\_ R \_\_\_\_\_

3. Miscellaneous S \_\_\_\_\_ T \_\_\_\_\_ R \_\_\_\_\_  
 Property in Sec. S \_\_\_\_\_ T \_\_\_\_\_ R \_\_\_\_\_

*Melissa DeVaugh*  
 REGISTER OF DEEDS  
 LAPEER COUNTY, MICHIGAN

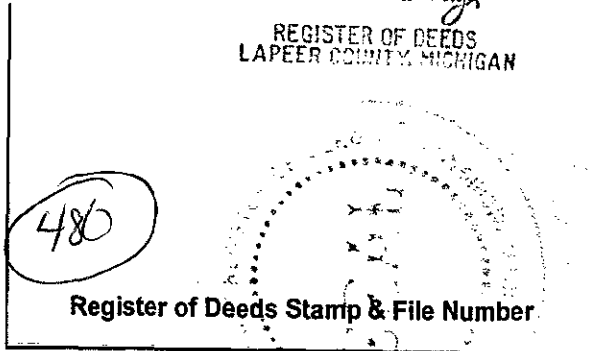

Register of Deeds Stamp & File Number

4. Lot No. \_\_\_\_\_, Recorded Plat \_\_\_\_\_  
 5. Private Claims \_\_\_\_\_

	A	B	C	D	E	F	G	H	I	J	K	L	M
1													
2	6	5	4	3	2	1							
3													
4	7	8	9	10	11	12							
5													
6	18	17	16	15	14	13							
7													
8	19	20	21	22	23	24							
9													
10	30	29	28	27	26	25							
11													
12	31	32	33	34	35	36							
13													

I, MICHAEL G. HAY, in a field survey on AUGUST 22, 1999, do hereby certify that under requirements of P.A. 74, Michigan P.A. of 1970, the corner points mentioned in lines 1 and 2 above were in conformance with regulations and rules therefore as required in the current manual of survey instructions of the United States Department of the Interior, Bureau of Land Management or by a decree of a Court of Law and/or that the corner points mentioned in lines 3, 4 and 5 above were in conformance with the rules of the Michigan Board of Land Surveyors or by a Decree of a Court of Law; established, re-established, monumented, re-monumented, recovered, found as expressed below:

**NOTE: Not more than 4 corners, all in the same town and range, may be recorded on this certificate.**

- A. Description of original monument and accessories and/or subsequent restoration:  
 1822- JOSEPH WAMPLER D.S. SET 1/2 MILE POST  
 1866- GILBERT BATES C.S. STONE 19 8 3  
 1987- HAROLD N. ELRICH P.S. 18986 (SURVEY) LIBER 7 PAGE 775 SET 1/2" IRON  
 1997- EARL E. GRAVLIN P.S. 23510 (SURVEY) LIBER 12 PAGE 360  
 1997- MICHAEL G. HAY P.S. 41101 (SURVEY) LIBER 12, PAGE 294 FOUND 1/2" IRON

PEER GROUP  
 APPROVED LAND CORNER  
 PA 345 OF 1990  
 LAPEER COUNTY  
 RAY DAVIS P.S. CO. SURVEYOR  
 DATE 12.2.1999

- B. Description of corner evidence found and/or method applied in restoring or reestablishing corner:  
 1999- MICHAEL G. HAY P.S. 41101 FOUND 1/2" IRON IN MON BOX, SEVEN FEET NORTH OF CENTER LINE OREGON ROAD (PAVED), FENCE-TREE LINE RUNNING NORTH.  
 F-13 TO G-13 2640.73' (M) 2640.58' (HBE) 2640.00' (GLO)  
 F-13 TO E-13 2624.44' (M) 2624.46' (GRAVLIN) 2640.00' (GLO)  
 F-13 TO F-1 (EAST) 105.13' (R&M)

- C. Description of monument for corner and accessories established to perpetuate locating the position of the corner:  
 SET STANDARD REMONUMENTATION CAP ON 1/2" IRON IN MON BOX  
 NORTH 26.28' P.K. NAIL IN FENCE POST  
 N 50 E 73.19' P.K. NAIL IN POWER POLE  
 N 45 W 40.04' P.K. NAIL IN FENCE POST  
 S 10 W 34.61' P.K. NAIL IN FENCE POST



Signed by Michael G. Hay Date 1-11-2000  
 Surveyor's Michigan License No. 41101

FORM APPROVED BY MICHIGAN STATE BOARD OF LAND SURVEYORS, JAN. 28, 1971

LIBER 0006 PAGE 0276

REVISED MAY 14, 1975  
 REVISED JAN., 1983  
 ADAPTED FOR WORD PROCESSING MARCH, 1993