

SURVEY & REMONUMENTATION

MAR 23 2000

SECTION

**REMONUMENTATION
LAND CORNER RECORDATION CERTIFICATE
Filing Requirement of Act 74, Mich. P.A. 1970**

**RECEIVED FOR RECORD
00 FEB 10 PM 2:18**

Melissa DeVaugh
**REGISTER OF DEEDS
LAPEER COUNTY, MICHIGAN**

For corners in

Corner Code #

LAPEER

(County)

Located In:
OREGON TWP.

G-13

1. Public Land Survey

T 8 R 9

T _____ R _____

T _____ R _____

T _____ R _____

2. Property Controlling in Section

S _____ T _____ R _____

S _____ T _____ R _____

3. Miscellaneous Property in Sec.

S _____ T _____ R _____

S _____ T _____ R _____

4. Lot No. _____ Recorded Plat _____

5. Private Claims _____

I, MICHAEL G. HAY, in a field survey on AUGUST 22, 1999, do hereby certify that under requirements of P.A. 74, Michigan P.A. of 1970, the corner points mentioned in lines 1 and 2 above were in conformance with regulations and rules therefore as required in the current manual of survey instructions of the United States Department of the Interior, Bureau of Land Management or by a decree of a Court of Law and/or that the corner points mentioned in lines 3, 4 and 5 above were in conformance with the rules of the Michigan Board of Land Surveyors or by a Decree of a Court of Law; established, re-established, monumented, re-monumented, recovered, found as expressed below:

NOTE: Not more than 4 corners, all in the same town and range, may be recorded on this certificate.

A. Description of original monument and accessories and/or subsequent restoration:

- 1822- JOSEPH WAMPLER D.S. SET POST FOR SECTION 33 AND 34
- 1866- GILBERT BATES C.S. STONE 23 7 31/2
- 1978- HAROLD N. ELRICH P.S. 18986 (SURVEY) LIBER 4 PAGE 464 FOUND 1/2" IRON
- 1979- BERNARD HENDERSON P.S. 16043 (SURVEY) LIBER 5 PAGES 482-483 FOUND 1/2" IRON
- 1983- BERNARD HENDERSON P.S. 16043 (SURVEY) LIBER 6 PAGES 579-580 FOUND 1/2" IRON
- 1985- HAROLD N. ELRICH P.S. 18986 (SURVEY) LIBER 6 PAGE 979 FOUND 1/2" IRON
- 1987- HAROLD N. ELRICH P.S. 18986 (SURVEY) LIBER 7 PAGE 775 FOUND 1/2" IRON
- 1994- LELAND D. BATES P.S. 21272 (SURVEY) LIBER 10 PAGE 861 FOUND 1/2" IRON MON BOX
- 1997- MICHAEL G. HAY P.S. 41101 (SURVEY) LIBER 12 PAGE 294 FOUND 1/2" IRON

**PEER GROUP
APPROVED LAND CORNER
PA 345 OF 1990
LAPEER COUNTY**


Ray Davis
**RAY DAVIS P.S. CO. SURVEYOR
DATE 12-2-1999**

B. Description of corner evidence found and/or method applied in restoring or reestablishing corner:

- 1999- MICHAEL G. HAY P.S. 41101 FOUND 1/2" IRON IN MON BOX ONE FOOT SOUTH OF CENTERLINE OREGON ROAD. FENCE- TREE LINE RUNNING NORTH.
- G-13 TO H-13 2641.34' (M) 2641.40' (HBE) 2640.00' (GLO)
- G-13 TO F-13 2640.73' (M) 2640.58' (HBE) 2640.00' (GLO)
- G-13 TO G-1 (EAST) 93.84' (R&M) 88.44' (134 GLO)

C. Description of monument for corner and accessories established to perpetuate locating the position of the corner:

- SET STANDARD REMONUMENTATION CAP ON 1/2" IRON IN MON BOX
- S 25 E 48.88' P.K. NAIL IN FENCE POST
- N 50 W 52.94' P.K. NAIL IN 12" HICKORY
- N 35 W 75.72' P.K. NAIL IN 8" PINE
- N 20 E 35.64' P.K. NAIL IN 14" CHERRY
- EAST 93.84' 1/2" IRON IN MON BOX

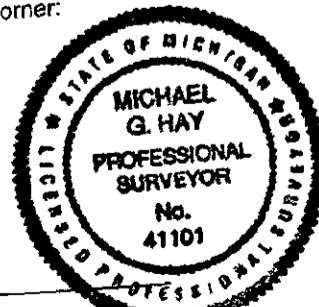

Signed by Michael G. Hay

Date 1-11-2000

Surveyor's Michigan License No. 41101

FORM APPROVED BY MICHIGAN STATE BOARD OF LAND SURVEYORS, JAN. 28, 1971

REVISED MAY 14, 1975
REVISED JAN., 1983
ADAPTED FOR WORD PROCESSING MARCH, 1985

LIBER 0006 PAGE 0277

	A	B	C	D	E	F	G	H	I	J	K	L	M
1													
2	6	5	4	3	2	1							
3													
4	7	8	9	10	11	12							
5													
6	18	17	16	15	14	13							
7													
8	19	20	21	22	23	24							
9													
10	30	29	28	27	26	25							
11													
12	31	32	33	34	35	36							
13													

481

Register of Deeds Stamp & File Number

902

α