

SURVEY & REMONUMENTATION

REMONUMENTATION

RECEIVED FOR RECORD

MAR 23 2000

LAND CORNER RECORDATION CERTIFICATE

00 FEB 10 PM 2:18


Filing Requirement of Act 74, Mich. P.A. 1970

SECTION

For corners in

Melissa DeVaugh
REGISTER OF DEEDS
LAPEER COUNTY, MICHIGAN

<u>LAPEER</u>	Located In:	Corner Code #
(County)	OREGON TWP.	
1. Public Land Survey	T <u>8 N</u> R <u>9 E</u>	<u>H-13</u>
	T _____ R _____	_____
	T _____ R _____	_____
	T _____ R _____	_____
2. Property Controlling in Section	S _____ T _____ R _____	_____
	S _____ T _____ R _____	_____
3. Miscellaneous Property in Sec.	S _____ T _____ R _____	_____
	S _____ T _____ R _____	_____

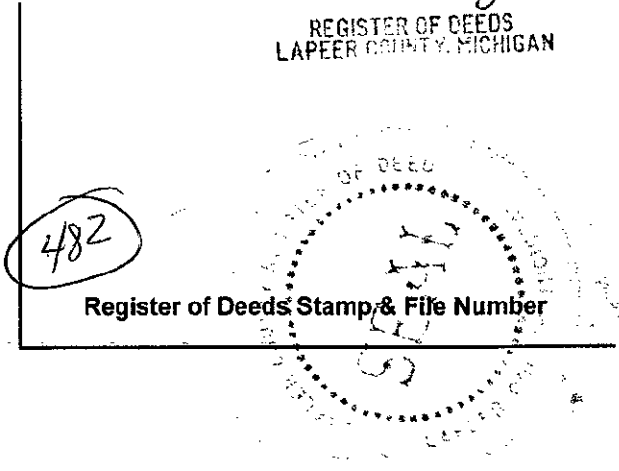

4. Lot No. _____, Recorded Plat _____
5. Private Claims _____

	A	B	C	D	E	F	G	H	I	J	K	L	M
1													
2	6	5	4	3	2	1							
3													
4	7	8	9	10	11	12							
5													
6	18	17	16	15	14	13							
7													
8	19	20	21	22	23	24							
9													
10	30	29	28	27	26	25							
11													
12	31	32	33	34	35	36							
13													

I, MICHAEL G. HAY, in a field survey on AUGUST 22, 1999, do hereby certify that under requirements of P.A. 74, Michigan P.A. of 1970, the corner points mentioned in lines 1 and 2 above were in conformance with regulations and rules therefore as required in the current manual of survey instructions of the United States Department of the Interior, Bureau of Land Management or by a decree of a Court of Law and/or that the corner points mentioned in lines 3, 4 and 5 above were in conformance with the rules of the Michigan Board of Land Surveyors or by a Decree of a Court of Law; established, re-established, monumented, re-monumented, recovered, found as expressed below:

NOTE: Not more than 4 corners, all in the same town and range, may be recorded on this certificate.


- A. Description of original monument and accessories and/or subsequent restoration:
 1822- JOSEPH WAMPLER D.S. SET 1/2 MILE POST
 1866- GILBERT BATES C.S. STONE 22 14 11
 1978- HAROLD N. ELRICH P.S. 18986 (SURVEY) LIBER 4 PAGE 464 FOUND 1/2" IRON
 1979- BERNARD HENDERSON P.S. 16043 (SURVEY) LIBER 5 PAGES 482-483 FOUND 1/2" IRON
 1979- BERNARD HENDERSON P.S. 16043 (LCRC) LIBER 5 PAGES 482-483 FOUND 1/2" IRON
 1983- BERNARD HENDERSON P.S. 16043 (SURVEY) LIBER 6 PAGES 579-580 FOUND 1/2" IRON
 1985- HAROLD N. ELRICH P.S. 18986 (SURVEY) LIBER 6 PAGES 978-979 FOUND 1/2" IRON
 1994- LELAND D. BATES P.S.-16699 (SURVEY) LIBER 10 PAGES 860-861 FOUND 1/2" IRON IN MON BOX

- B. Description of corner evidence found and/or method applied in restoring or reestablishing corner:
 1999-MICHAEL G. HAY P.S. 41101 FOUND 1/2" IRON MON BOX IN CENTER LINE OF OREGON ROAD WITH FENCE LINE RUNNING NORTH.
 H-13 TO I-13 2640.17' (M) 2640.00' (40 GLO)
 H-13 TO G-13 2641.34' (M) 2641.40' (HBE) 2640.00' (40 GLO)
 H-13 TO H-1 (EAST) 73.72' (R&M)

PEER GROUP
APPROVED LAND CORNER
PA 345 OF 1990
LAPEER COUNTY

- C. Description of monument for corner and accessories established to perpetuate locating the position of the corner:
 SET STANDARD REMONUMENTATION CAP ON 1/2" IRON MON BOX.
 EAST 73.72' 1/2" IRON IN MON BOX
 S 40 E 47.10' P.K. NAIL IN CONCRETE SLAB
 N 50 E 55.28' P.K. NAIL IN 8" POPLAR
 S 30 E 38.98' SPIKE WITH REMON TAG TWIN 12" POPLAR

MICHAEL G. HAY
S. CO. SURVEYOR
DATE 12-2-1999

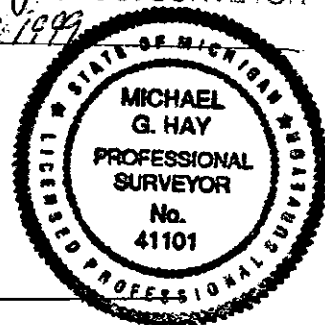

Signed by Michael G. Hay Date 1-11-2000
 Surveyor's Michigan License No. 41101

FORM APPROVED BY MICHIGAN STATE BOARD OF LAND SURVEYORS, JAN. 28, 1971