

SURVEY & REMONUMENTATION

MAR 23 2000

SECTION

**REMONUMENTATION
LAND CORNER RECORDATION CERTIFICATE
Filing Requirement of Act 74, Mich. P.A. 1970**

RECEIVED FOR RECORD

00 FEB 10 PM 2:18


Melissa DeVough
REGISTER OF DEEDS
LAPEER COUNTY, MICHIGAN

For corners in

LAPEER Located In: OREGON TWP. Corner Code # I-13
(County)

1. Public Land Survey	T <u>8</u> N	R <u>9</u> E	_____
	T _____	R _____	_____
	T _____	R _____	_____
	T _____	R _____	_____
2. Property Controlling in Section	S _____	T _____	R _____
	S _____	T _____	R _____
3. Miscellaneous Property in Sec.	S _____	T _____	R _____
	S _____	T _____	R _____

4. Lot No. _____ Recorded Plat _____
5. Private Claims _____

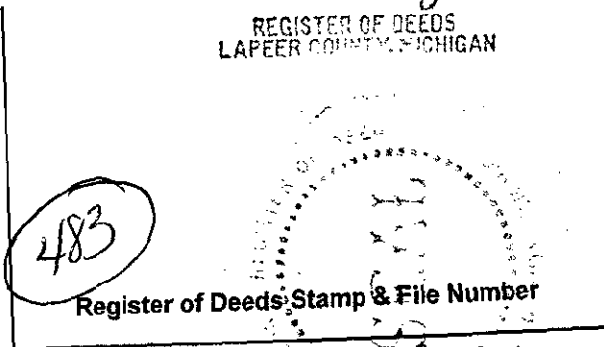

	A	B	C	D	E	F	G	H	I	J	K	L	M
1													
2	6	5	4	3	2	1							
3													
4	7	8	9	10	11	12							
5													
6	18	17	16	15	14	13							
7													
8	19	20	21	22	23	24							
9													
10	30	29	28	27	26	25							
11													
12	31	32	33	34	35	36							
13													

I, MICHAEL G. HAY, in a field survey on AUGUST 22, 1999, do hereby certify that under requirements of P.A. 74, Michigan P.A. of 1970, the corner points mentioned in lines 1 and 2 above were in conformance with regulations and rules therefore as required in the current manual of survey instructions of the United States Department of the Interior, Bureau of Land Management or by a decree of a Court of Law and/or that the corner points mentioned in lines 3, 4 and 5 above were in conformance with the rules of the Michigan Board of Land Surveyors or by a Decree of a Court of Law; established, re-established, monumented, re-monumented, recovered, found as expressed below:

NOTE: Not more than 4 corners, all in the same town and range, may be recorded on this certificate.


- A. Description of original monument and accessories and/or subsequent restoration:
 1822- JOSEPH WAMPLER D.S. SET POST CORNER SECTION 34 AND 35
 1866- GILBERT BATES C.S. STONE 19 12 7
 1996- HAROLD N. ELRICH P.S. 18986 (SURVEY) LIBER 11 PAGE 838 FOUND IRON ROD IN MON BOX
 1999- MARK W. POWELL P.S. 44298 (SURVEY) LIBER 13 PAGE 74 FOUND 5/8" IRON IN MON BOX

- B. Description of corner evidence found and/or method applied in restoring or reestablishing corner:
 1999- MICHAEL G. HAY P.S. 41101 FOUND 5/8" IRON IN MON BOX ON CENTER LINE OF OREGON ROAD (PAVED) AND GRAY ROAD (PAVED) TO THE NORTH.
 I-13 TO J-13 2617.86' (M) 2617.86' (HBE) 2640.00' (40 GLO) 2638.68' (39.98 COUNTY)
 I-13 TO H-13 2640.17'(M) 2640.00' (40 GLO)
 I-13 TO I-1 EAST 65.49' (R&M) 76.20' (127 GLO)

- C. Description of monument for corner and accessories established to perpetuate locating the position of the corner:
 SET STANDARD REMONUMENTATION CAP ON 1/2" IRON IN MON BOX
 S 10 E 75.15' NAIL WEST FACE 12" ELM
 N 80 E 142.48' NAIL SOUTH FACE 30" OAK
 S 80 E 103.61' NAIL SOUTH FACE UTILITY POLE
 EAST 65.49' NW CORNER SECTION 2, T7N-R9E

PEER GROUP
APPROVED LAND CORNER
PA 845 OF 1990
LAPEER COUNTY

DATE 12-2-1999

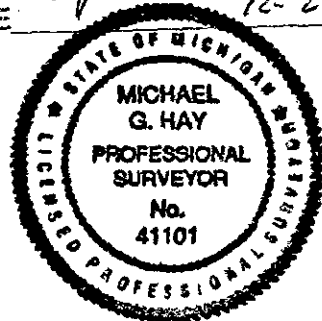

Signed by Michael G. Hay Date 1-11-2000
Surveyor's Michigan License No. 41101

FORM APPROVED BY MICHIGAN STATE BOARD OF LAND SURVEYORS, JAN. 22, 1971

REVISED MAY 14, 1975
REVISED JAN., 1983
ADAPTED FOR WORD PROCESSING MARCH, 1993