

SURVEY & REMONUMENTATION

MAR 29 2000

SECTION

**REMONUMENTATION
LAND CORNER RECORDATION CERTIFICATE**
Filing Requirement of Act 74, Mich. P.A. 1970

RECEIVED FOR RECORD

00 FEB 10 PM 2:18


For corners in

LAPEER
(County)

Located In:
OREGON TWP.

Corner Code #

- | | | | |
|------------------------------------|--------------|--------------|-------------|
| 1. Public Land Survey | T <u>8</u> N | R <u>9</u> E | <u>J-13</u> |
| | T _____ | R _____ | _____ |
| | T _____ | R _____ | _____ |
| | T _____ | R _____ | _____ |
| 2. Property Controlling in Section | S _____ | T _____ | R _____ |
| | S _____ | T _____ | R _____ |
| 3. Miscellaneous Property in Sec. | S _____ | T _____ | R _____ |
| | S _____ | T _____ | R _____ |

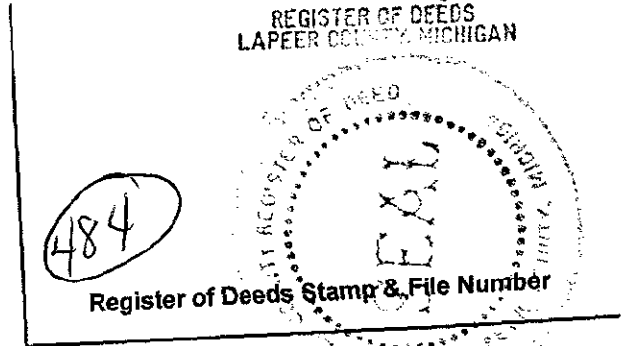

4. Lot No. _____, Recorded Plat _____
5. Private Claims _____

	A	B	C	D	E	F	G	H	I	J	K	L	M
2	6	5	4	3	2	1							
3													
4	7	8	9	10	11	12							
5													
6	18	17	16	15	14	13							
7													
8	19	20	21	22	23	24							
9													
10	30	29	28	27	26	25							
11													
12	31	32	33	34	35	36							
13													

I, MICHAEL G. HAY, in a field survey on AUGUST 22, 1999, do hereby certify that under requirements of P.A. 74, Michigan P.A. of 1970, the corner points mentioned in lines 1 and 2 above were in conformance with regulations and rules therefore as required in the current manual of survey instructions of the United States Department of the Interior, Bureau of Land Management or by a decree of a Court of Law and/or that the corner points mentioned in lines 3, 4 and 5 above were in conformance with the rules of the Michigan Board of Land Surveyors or by a Decree of a Court of Law; established, re-established, monumented, re-monumented, recovered, found as expressed below:

NOTE: Not more than 4 corners, all in the same town and range, may be recorded on this certificate.

PEER GROUP
APPROVED LAND CORNER
PA 345 OF 1990
LAPEER COUNTY

A. Description of original monument and accessories and/or subsequent restoration:

- 1822- JOSEPH WAMPLER D.S. SET 1/2 MILE POST
- 1866- GILBERT BATES C.S. STONE 23 12 11
- 1993- HAROLD N. ELRICH P.S. 18986 (SURVEY) LIBER 10 PAGE 111 FOUND P.K. NAIL
- 1996- HAROLD N. ELRICH P.S. 18986 (SURVEY) LIBER 11 PAGES 491-492 FOUND P.K. NAIL
- 1996- HAROLD N. ELRICH P.S. 18986 (SURVEY) LIBER 11 PAGE 838 FOUND 1/2" IRON MON BOX
- 1998- MICHAEL G. HAY P.S. 41101 (SURVEY) LIBER 12 PAGE 776 FOUND 1/2" IRON MON BOX
- 1998- MICHAEL G. HAY P.S. 41101 (SURVEY) LIBER 12 PAGE 811 FOUND 1/2" IRON MON BOX
- 1999- CHARLES T. LILLIEBERG P.S. 40162 (SURVEY) LIBER 13 PAGE 157 FOUND 1/2" IRON MON BOX
- 1999- MARK W. POWELL P.S. 44298 (SURVEY) LIBER 13 PAGE 74 FOUND 1/2" IRON MON BOX

B. Description of corner evidence found and/or method applied in restoring or reestablishing corner:

- 1999- MICHAEL G. HAY P.S. 41101 FOUND 1/2" IRON IN MON BOX, 0.30' NORTH OF CENTER LINE OREGON ROAD (PAVED) AND ON CENTERLINE OF HAYES ROAD (GRAVEL) RUNNING NORTH.
- J-13 TO K-13 2638.65' (M) 2640.00' (40 GLO)
- J-13 TO I-13 2617.86' (M) 2640.00' (40 GLO) 2638.68' (39.98 COUNTY) 2617.86 (HBE)
- J-13 TO J-1 (EAST) 46.18' (R&M)

C. Description of monument for corner and accessories established to perpetuate locating the position of the corner:

- SET STANDARD REMONUMENTATION CAP ON 1/2" IRON MON BOX
- N 50 W 43.03'
- N 45 E 79.02'
- S 20 W 63.79'
- EAST 46.18'
- SE FACE DETROIT WATER MARKER
- NAIL IN SE FACE OF POWER POLE
- NAIL IN W. FACE OF 10" WILLOW
- NORTH 1/4 CORNER OF SECTION 2, T7N-R9E



Signed by Michael G. Hay Date 1-11-2000
Surveyor's Michigan License No. 41101

FORM APPROVED BY MICHIGAN STATE BOARD OF LAND SURVEYORS, JAN. 26, 1971

REVISED MAY 14, 1976
REVISED JAN., 1983
ADAPTED FOR WORD PROCESSING MARCH, 1993