

MAR 29 1999

REMONUMENTATION

LAND CORNER RECORDATION CERTIFICATE

Filing Requirement of Act 74, Mich. P.A. 1970

SECTION

For corners in

Lapeer

(County)

Located In: OREGON TWP.

Corner Code #

RECEIVED FOR RECORD

99 JAN -6 PM 1:41

Melissa DeVaugh REGISTER OF DEEDS LAPEER COUNTY MICHIGAN

447

Register of Deeds Stamp & File Number

- 1. Public Land Survey T 8 R 9 K-4
2. Property Controlling in Section S T R
3. Miscellaneous Property in Sec. S T R

- 4. Lot No. Recorded Plat
5. Private Claims

I, MICHAEL G. HAY, in a field survey on MARCH 3 1998, do hereby certify that under requirements of P.A. 74, Michigan P.A. of 1970, the corner points mentioned in lines 1 and 2 above were in conformance with regulations and rules therefore as required in the current manual of survey instructions of the United States Department of the Interior, Bureau of Land Management or by a decree of a Court of Law and/or that the corner points mentioned in lines 3, 4 and 5 above were in conformance with the rules of the Michigan Board of Land Surveyors or by a Decree of a Court of Law; established, re-established, monumented, re-monumented, recovered, found as expressed below:

NOTE: Not more than 4 corners, all in the same town and range, may be recorded on this certificate.

A. Description of original monument and accessories and/or subsequent restoration:

- 1821-JOSEPH WAMPLER D.S. SET POST PINE 32 S78W 64, BEECH 7 N52E 27
1864-GILBERT BATES C.S. PINE STUMP 32 S57E 36, ORIGINAL PINE STUMP 34 S78W 64
1972-SHELDON R. BROWN P.S. 17613 L1 P705 FOUND SPIKE S29E 56.16 25" MAPLE
S85W 24.53' POWER POLE
N57E 47.28' 24" MAPLE
1972-SHELDON R. BROWN P.S. 17613 L2 P515-516 LAND CORNERS RECORDATION CERTIFICATE (SAME AS 1972 TIES)
1974-HAROLD N. ELRICH P.S. 18986 L3 P28 FOUND 1/2" IRON S85W 27.12' UTILITY POLE
S29E 56.38' 25" MAPLE
N57E 44.38' 24" MAPLE

(CONTINUED ON BACK)


B. Description of corner evidence found and/or method applied in restoring or reestablishing corner:

1998- MICHAEL G. HAY P.S. 41101 FOUND 1/2" IRON IN MON BOX AT CENTER LINE CENTER LINE OF FLINT RIVER ROAD AT McKEEN LAKE ROAD FENCE LINE RUNNING TO THE WEST. RECOVERED 3 WITNESSES CLOSE TO RECORDED DISTANCES.

- K-4 TO K-3 2634.09 (M) 2634.83 (R-KAY) 2634.03 (R-HBE) 2634.03 (R-GRAVLIN)
K-4 TO L-4 2653.37 (M) 2653.32 (R-HBE)
K-4 TO K-5 2656.15 (M) 2656.13 (R-GRAVLIN)

C. Description of monument for corner and accessories established to perpetuate locating the position of the corner:

K-4 SET STANDARD REMONUMENTATION CAP ON 1/2" IRON ROD IN MONUMENTATION BOX WEST 33.82' NAIL IN NORTH FACE OF 18" TWIN CHERRY N30W 64.08' P.K. IN NE FACE OF 12" WHITE PINE N25E 83.80' NAIL IN NW FACE OF 18" CEDAR N80E 75.28' NAIL IN NW FACE OF 30" MAPLE

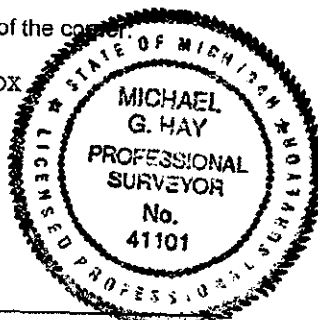

Signed by Michael G. Hay

Date 12-30-98

Surveyor's Michigan License No. 41101

MAR 29 1999

SECTION

1974-ROBERT G. KAY P.S. 14096 L2 P579 S29E 56.16' 25" MAPLE
S85W 24.53' P.POLE
N57E 47.28' 24" MAPLE

1976-HAROLD N. ELRICH P.S. 18986 L3 P857 FOUND 1/2" IRON (SAME AS ELRICH SURVEY 1924)

1978-PAUL E. PANGUS P.S. 21576 L005 P393 FOUND 1/2" REROD N45E 45.10' 28" OAK
S45E 56.80' 32" OAK
S80W 27.34' TELEPHONE POLE

1979-JAMES A. BECK P.S. 21559 L005 P337 FOUND SPIKE
(SAME AS 1972 TIES)

1985-RAY D. DAVIS P.S. 22430 L006 P950 FOUND 1/2" IRON WEST 27.33' P.K. IN P.POLE
NE 45.11' P.K. 26" OAK
SW 84.14' P.K. 27" OAK

1985-RAY D. DAVIS P.S. 22430 L006 P951 FOUND 1/2" IRON WEST 27.33' P.K. IN P.POLE
NE 45.11' P.K. 26" OAK
SE 56.87' P.K. STUMP
SW 84.14' P.K. 27" OAK

1987-RAY D. DAVIS P.S. 22430 L007 P763 FOUND 1/2" IRON ROD WEST 27.33 P.K. IN P.POLE
NE 45.11' P.K. 26" OAK
SE 56.87' P.K. IN STUMP

1989-HAROLD N. ELRICH P.S. 18986 L8 P412 FOUND 1/2" IRON (SAME AS 1987 TIES)

1991-RAY D. DAVIS P.S. 22430 L009 P490 FOUND 1/2" IRON IN MON BOX
WEST 33.79' SPIKE 14" CHERRY
N30W 64.03' P.K. NAIL 12" PINE
N75E 75.29' P.K. 20" MAPLE
S70E 87.00' P.K. 20" PINE

1991-HAROLD N. ELRICH P.S. 18986 L009 P273-275 RESET COR USING SURVEY RECORDED IN L006 P951
(SET P.K. NAIL)
S20W 84.14' NAIL 27" OAK
N85W 33.77' 14" TWIN CHERRY
S75E 86.70' 20" PINE
N35E 83.70' 10" CEDAR

1992-EARL E. GRAVLIN P.S. 23510 L009 P805 FOUND 1/2" IRON ROD NE 45.11' P.K. P.POLE
SE 56.87' P.K. IN STUMP
SW 84.14' P.K. 22" OAK

1993-EARL E. GRAVLIN P.S. 23510 L10 P257 FOUND 1/2" IRON IN MON BOX
N25E 83.75' NAIL 12" CEDAR
WEST 33.77' NAIL 18" CHERRY
N30W 63.98' NAIL 8" CHERRY

1993-HAROLD N. ELRICH P.S. 18986 L010 P106 S20W 84.14' NAIL 27" OAK
N85W 33.77' 14" TWIN CHERRY
S75E 86.70' 20" PINE
N35E 83.70' 10" CEDAR

1993-EARL E. GRAVLIN P.S. 23510 L10 P441 FOUND 1/2" IRON MON BOX
N25E 83.75' NAIL 12" CHERRY
WEST 33.77' NAIL 18" CHERRY
N30W 63.98' NAIL 8" CHERRY

1994-RAY D. DAVIS P.S. 22430 L0010 P0818 FOUND 1/2" IRON MON BOX
WEST 33.77' SPIKE 18" CHERRY
N30W 64.00' P.K. 12" PINE
N75E 75.29' P.K. 20" MAPLE
S70E 87.00' P.K. 20" PINE

1994-EARL E. GRAVLIN P.S. 23510 L10 P813 FOUND 1/2" IRON IN MON BOX
N25E 83.75' NAIL 12" CEDAR
WEST 33.77' NAIL 18" CHERRY
N30W 63.98' NAIL 8" CHERRY

1997-RAY D. DAVIS P.S. 22430 L0011 P0973 FOUND 1/2" IRON IN MON BOX
N25W 83.75' SPIKE 12" CEDAR
WEST 33.77' SPIKE 18" CHERRY
N30W 63.98' SPIKE 8" CHERRY
S75E 86.70' SPIKE 20" PINE

RECORDED
APR 13 1999

Ray D. Davis
9-17-98