

SURVEY & REMONUMENTATION

MAR 23 2000

REMONUMENTATION

RECEIVED FOR RECORD

SECTION LAND CORNER RECORDATION CERTIFICATE

00 FEB 10 PM 2:18

Filing Requirement of Act 74, Mich. P.A. 1970


For corners in

LAPEER Located In: OREGON TWP. Corner Code # _____
 (County)

1. Public Land Survey T 8 N R 9 E K-13
 T _____ R _____
 T _____ R _____
 T _____ R _____

2. Property Controlling S _____ T _____ R _____
 in Section S _____ T _____ R _____

3. Miscellaneous S _____ T _____ R _____
 Property in Sec. S _____ T _____ R _____

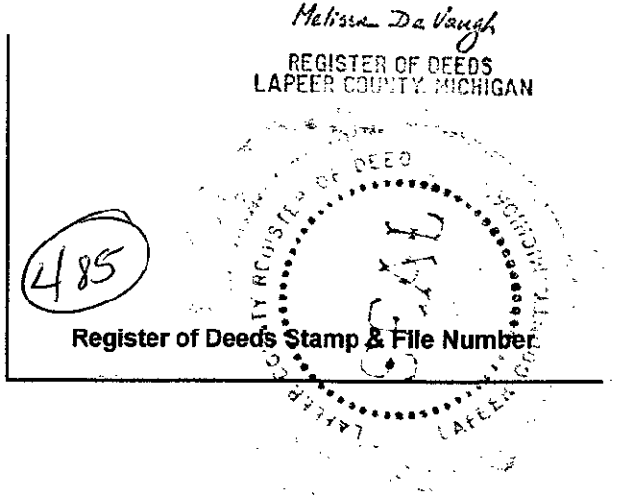

4. Lot No. _____, Recorded Plat _____
 5. Private Claims _____

	A	B	C	D	E	F	G	H	I	J	K	L	M
1													
2	6	5	4	3	2	1							
3													
4	7	8	9	10	11	12							
5													
6	18	17	16	15	14	13							
7													
8	19	20	21	22	23	24							
9													
10	30	29	28	27	26	25							
11													
12	31	32	33	34	35	36							
13													

I, MICHAEL G. HAY, in a field survey on AUGUST 22, 1999, do hereby certify that under requirements of P.A. 74, Michigan P.A. of 1970, the corner points mentioned in lines 1 and 2 above were in conformance with regulations and rules therefore as required in the current manual of survey instructions of the United States Department of the Interior, Bureau of Land Management or by a decree of a Court of Law and/or that the corner points mentioned in lines 3, 4 and 5 above were in conformance with the rules of the Michigan Board of Land Surveyors or by a Decree of a Court of Law; established, re-established, monumented, re-monumented, recovered, found as expressed below:

NOTE: Not more than 4 corners, all in the same town and range, may be recorded on this certificate.

- A. Description of original monument and accessories and/or subsequent restoration:
 1822- JOSEPH WAMPLER D.S. SET POST CORNER SECTION 35 AND 36
 1867- GILBERT BATES C.S. STONE ABOUT 16 IN LONG PLOW POINT
 1978- BERNARD HENDERSON P.S. 16043 (SURVEY) LIBER 4 PAGES 868-869 SET 1/2" IRON
 1997- HAROLD N. ELRICH P.S. 18986 (SURVEY) LIBER 11 PAGE 938 FOUND 1/2" IRON IN MON BOX
 1999- CHARLES T. LILLIEBERG P.S. 40162 (SURVEY) LIBER 13, PAGE 157 FOUND 1/2" IRON MON BOX

- B. Description of corner evidence found and/or method applied in restoring or reestablishing corner:
 1999- MICHAEL G. HAY P.S. 41101 FOUND 1/2" IRON IN MON BOX 5.50' NORTH OF CENTERLINE OREGON ROAD. TREE LINE RUNNING NORTH AND SOUTH
 K-13 TO L-13 2635.85'(M) 2640.00' (40 GLO)
 K-13 TO J-13 2638.65' (M) 2640.00' (40 GLO)
 K-13 TO K-1 (EAST) 2.64' (R&M) 6.60' (10 GLO)

APPROVED LAND CORNER
 PA 345 OF 1990
 LAPEER COUNTY
 RAY DAVIS P.S. CO. SURVEYOR
 DATE 12-2-1999

- C. Description of monument for corner and accessories established to perpetuate locating the position of the corner:
 SET STANDARD REMONUMENTATION CAP ON 1/2" IRON IN MON BOX
 N 05 E 28.81' NAIL WEST FACE 22" MAPLE
 N 30 E 35.18' P.K. NAIL EAST FACE 28" MAPLE
 S 40 E 41.58' NAIL WEST FACE 6" ELM
 S 50 E 60.02' NAIL SW FACE 8" ELM
 EAST 2.64' 1/2" IRON IN MON BOX



Signed by Michael G. Hay Date 1-11-2000
 Surveyor's Michigan License No. _____