

**SURVEY &
REMONUMENTATION**

MAR 23 2000

REMONUMENTATION

LAND CORNER RECORDATION CERTIFICATE

Filing Requirement of Act 74, Mich. P.A. 1970

RECEIVED FOR RECORD

00 FEB 10 PM 2:18

SECTION

For corners in

Lapeer Located In: Lapeer Twp. Corner Code #
(County) OREGON


1. Public Land Survey T 8 R 9 L-13
T _____ R _____
T _____ R _____
T _____ R _____

2. Property Controlling S _____ T _____ R _____
in Section S _____ T _____ R _____

3. Miscellaneous S _____ T _____ R _____
Property in Sec. S _____ T _____ R _____

4. Lot No. _____ Recorded Plat _____

5. Private Claims _____

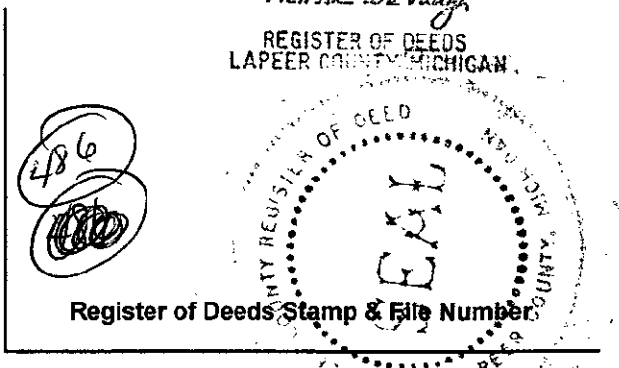

	A	B	C	D	E	F	G	H	I	J	K	L	M
1													
2	6	5	4	3	2	1							
3													
4	7	8	9	10	11	12							
5													
6	18	17	16	15	14	13							
7													
8	19	20	21	22	23	24							
9													
10	30	29	28	27	26	25							
11													
12	31	32	33	34	35	36							
13													

I, MICHAEL G. HAY, in a field survey on AUGUST 22, 1999, do hereby certify that under requirements of P.A. 74, Michigan P.A. of 1970, the corner points mentioned in lines 1 and 2 above were in conformance with regulations and rules therefore as required in the current manual of survey instructions of the United States Department of the Interior, Bureau of Land Management or by a decree of a Court of Law and/or that the corner points mentioned in lines 3, 4 and 5 above were in conformance with the rules of the Michigan Board of Land Surveyors or by a Decree of a Court of Law; established, re-established, monumented, re-monumented, recovered, found as expressed below:

NOTE: Not more than 4 corners, all in the same town and range, may be recorded on this certificate.


A. Description of original monument and accessories and/or subsequent restoration:
1822- JOSEPH WAMPLER D.S. SET 1/2 MILE POST

FEER GROUP
APPROVED LAND CORNER
PA 345 OF 1990
LAPEER COUNTY

Ray Davis
RAY DAVIS P.S. CO. SURVEYOR
DATE 12-22-1999

B. Description of corner evidence found and/or method applied in restoring or reestablishing corner:
1999- MICHAEL G. HAY P.S. # 41101 NO CORNER FOUND. NO OCCUPATION NORTH OR SOUTH.
SET SOUTH 1/4 CORNER ON LINE BETWEEN K-13 AND L-1 AND 1/2 THE DISTANCE BETWEEN K-13 AND M-13
L-13 TO M-13 2635.87' 2640.00' (40 GLO)
L-13 TO K-13 2635.86' 2640.00' (40 GLO)
L-13 TO L-1 1.34' NORTH (M)

C. Description of monument for corner and accessories established to perpetuate locating the position of the corner:
SET STANDARD REMONUMENTATION CAP ON 1/2" IRON IN MON BOX
S30E 64.41' FND NAIL IN NE FACE 15" ELM
S70W 46.21' FND NAIL IN NNW FACE 10" ELM
S65W 72.88' FND NAIL IN SE FACE POWER POLE
N05W 38.53' FND NAIL & TAG #40162 IN E FACE 14" SPRUCE
N40E 60.17' FND NAIL & TAG #40162 IN SE FACE 15" OAK

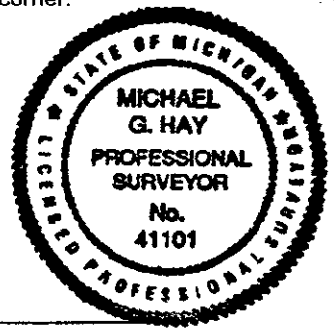

Signed by Michael G. Hay Date 1-11-2000
Surveyor's Michigan License No. 41101