

SURVEY & REMONUMENTATION

APR 28 1995

COMMISSION

REMONUMENTATION

LAND CORNER RECORDATION CERTIFICATE
Filing Requirement of Act 74, Mich. P.A. 1970

For corners in

<u>LAPEER</u> <small>County</small>	Located In:	Corner Code #
1. Public Land Survey	T <u>8N</u> R <u>9E</u>	<u>M-5</u>
	T _____ R _____	_____
	T _____ R _____	_____
	T _____ R _____	_____
2. Property Controlling in Section	S _____ T _____ R _____	_____
	S _____ T _____ R _____	_____
3. Miscellaneous Property in Sec.	S _____ T _____ R _____	_____
	S _____ T _____ R _____	_____
4. Lot No. _____, Recorded Plat _____		
5. Private Claims _____		

RECEIVED FOR RECORD

95 OCT -6 PM 1:12

LIBER NO. 005 PAGE NO. 290 -
Melissa D. Vaughn 291
 REGISTER OF DEEDS
 LAPEER COUNTY, MICHIGAN

Register of Deeds Stamp & File Number

I, HAROLD N. ELRICH, in a field survey on AUGUST 22, 19 95, do hereby certify that under requirements of P.A. 74, Michigan P.A. of 1970, the corner points mentioned in lines 1 and 2 above were in conformance with regulations and rules therefore as required in the current manual of survey instructions of the United States Department of the Interior, Bureau of Land Management or by a decree of a Court of Law and/or that the corner points mentioned in lines 3, 4 and 5 above were in conformance with the rules of the Michigan Board of Land Surveyors or by a Decree of a Court of Law: established, re-established, monumented, re-monumented, recovered, found as expressed below:

A	B	C	D	E	F	G	H	I	J	K	L	M
2	6		5		4		3		2		1	
3												
4	7		8		9		10		11		12	
5												
6	18		17		16		15		14		13	
7												
8	19		20		21		22		23		24	
9												
10	30		29		28		27		26		25	
11												
12	31		32		33		34		35		36	
13												

NOTE: Not more than 4 corners, all in the same town and range, may be recorded on this certificate.

A. Description of original monument and accessories and/or subsequent restoration:

- 1822 WAMPLER D.S. SET POST-CORNERS 12 & 13, PINE 32" N 2 1/2° W 24 LINKS, BEECH 12" S 32 1/2° W 42 LINKS
- 1868 GILBERT BATES - STAKE - PINE 34" S 70° W 20 LINKS
- 1972 HENDERSON P.S. LAND CORNER RECORDATION CERTIFICATE - LIBER 002, PAGE 039- SET NAIL & CAP, N 40° W 36.38 FEET 10" TWIN CHERRY, N 60° E 46.00 FEET 30" OAK, S 50° E 49.12 FEET 18" HICKORY
- 1976 BATES P.S. (SURVEY) LIBER 003, PAGE 575 FOUND NAIL & CAP - SAME WITNESSES AS 1972 LAND CORNER RECORDATION CERTIFICATE
- 1976 BATES P.S. (SURVEY) LIBER 003, PAGE 576 FOUND NAIL & CAP - SAME WITNESSES AS 1972 LAND CORNER RECORDATION CERTIFICATE (SEE BACK)

B. Description of corner evidence found and/or method applied in restoring or reestablishing corner:

1995 ELRICH P.S. FOUND 1/2" IRON IN MONUMENT BOX 0.5 FEET EAST OF CENTERLINE OF MILLVILLE ROAD. THERE IS A TREE LINE, STUMP ROW AND BARB-WIRE FENCE GOING WEST OPPOSITE 1/2" IRON FOUND. FOUND TWO WITNESSES FROM PREVIOUS SURVEYS THAT LOCATE 1/2" IRON FOUND. GLO NOTES INDICATE 170 LINKS NORTH TO SOUTHWEST CORNER OF SECTION 7, T8N-R10E, MAYFIELD TOWNSHIP. MEASURED 92.46 FEET

ACCEPTED 1/2" IRON FOUND AS BEST LOCATION OF SOUTHEAST CORNER OF SECTION 12, T8N-R9E, OREGON TOWNSHIP, LAPEER COUNTY, MICHIGAN

MEASURED REFERENCES - M-5 TO M-4 2659.45 FEET
 M-5 TO M-6 2649.80 FEET
 M-5 TO L-5 2655.23 FEET

C. Description of monument for corner and accessories established to perpetuate locating the position of the corner:

M-5 PLACED LAPEER COUNTY REMONUMENTATION CAP ON 1/2" IRON FOUND

SET NEW WITNESSES - N 40° W 36.86 FEET P.K. NAIL & WASHER IN 12" CHERRY
 N 30° E 46.00 FEET P.K. NAIL & WASHER IN 31" OAK
 S 85° E 31.05 FEET P.K. NAIL & WASHER IN 8" WHITE PINE
 S 20° E 48.00 FEET P.K. NAIL & WASHER IN 18" HICKORY
 NORTH 92.46 FEET FOUND IRON IN MONUMENT BOX- SOUTHWEST CORNER OF SECTION 7, T8N-R10E, MAYFIELD TOWNSHIP, LAPEER COUNTY, MICHIGAN

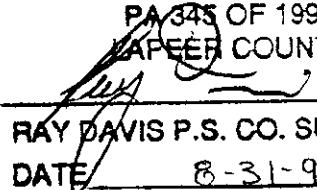
Signed by Harold N. Elrich Date 9/26/95
 Surveyor's Michigan License No. 18986

LIBER 0005 PAGE 0290

A. (CONTINUED)

- 1980 BECK P.S. (SURVEY) LIBER 006, PAGE 015 FOUND 3/4" ROD
ONE FOOT DEEP - SET 1/2" ROD ABOVE, N 40° W 36.33 FEET
NAIL IN SOUTHERN MOST 10" TWIN CHERRY, N 60°E 46.30
FEET NAIL IN 30" OAK, S 50° E 47.68 FEET 18" HICKORY
- 1988 GRAVLIN P.S. (SURVEY) LIBER 007, PAGE 996 - FOUND 1/2"
IRON - SAME WITNESSES AS 1980 SURVEY
- 1994 ELRICH P.S. (SURVEY) LIBER 010, PAGE 694 FOUND 1/2" IRON
IN MONUMENT BOX - NO WITNESSES

PEER GROUP
APPROVED LAND CORNER
PA 345 OF 1990
LAPEER COUNTY


RAY DAVIS P.S. CO. SURVEYOR
DATE 8-31-95

MISC D	9.00
REMLC	20075
REMOBT	2.00