

**SURVEY &
REMONUMENTATION**

1993

COMMISSION

**REMONUMENTATION
LAND CORNER RECORDATION CERTIFICATE
Filing Requirement of Act 74, Mich. P.A. 1970**

RECEIVED FOR RECORD

93 DEC 22 PM 2:48

LIBER 005 PAGE 14-15

Harold N. Elrich
REGISTERED PROFESSIONAL SURVEYOR
LAPEER COUNTY, MICHIGAN

For corners in

LAPEER
(County)

Located In:

Corner Code #

- | | | |
|---------------------------------------|-------------------------|-------------|
| 1. Public Land Survey | T <u>8N</u> R <u>9E</u> | <u>M-10</u> |
| | T _____ R _____ | _____ |
| | T _____ R _____ | _____ |
| | T _____ R _____ | _____ |
| 2. Property Controlling in Section | S _____ T _____ R _____ | _____ |
| | S _____ T _____ R _____ | _____ |
| 3. Miscellaneous Property in Sec. | S _____ T _____ R _____ | _____ |
| | S _____ T _____ R _____ | _____ |
| 4. Lot No. _____, Recorded Plat _____ | | |
| 5. Private Claims _____ | | |

Register of Deeds Stamp & File Number

I, HAROLD N. ELRICH in a field survey on NOVEMBER, 19 93, do hereby certify that under requirements of P.A. 74, Michigan P.A. of 1970, the corner points mentioned in lines 1 and 2 above were in conformance with regulations and rules therefore as required in the current manual of survey instructions of the United States Department of the Interior, Bureau of Land Management or by a decree of a Court of Law and/or that the corner points mentioned in lines 3, 4 and 5 above were in conformance with the rules of the Michigan Board of Land Surveyors or by a Decree of a Court of Law; established, re-established, monumented, re-monumented, recovered, found as expressed below:

NOTE: Not more than 4 corners, all in the same town and range, may be recorded on this certificate.


	A	B	C	D	E	F	G	H	I	J	K	L	M
2	6		5		4		3		2		1		
3													
4	7		8		9		10		11		12		
5													
6	18		17		16		15		14		13		
7													
8	19		20		21		22		23		24		
9													
10	30		29		28		27		26		25		
11													
12	31		32		33		34		35		36		
13													

- A. Description of original monument and accessories and/or subsequent restoration:
- ORIGINAL GLO SURVEY BY JOS. WAMPLER D.S. SET 1/2 MILE POST LIN 7" N 39° W 17 LINKS & MAPLE 32" S 31° W 44 LINKS
 - 1906 SURVEY BY SICKLESTEEL SET STAKE & BRICK PINE 36° S 34° W 162 LINKS & PINE 32" S 50° W 160 OR 166 LINKS
 - 1971 RECORDED SURVEY L 001, PG. 29 SET 1/2" IRON ROD BASED ON OCCUPATION OF FENCE HENDERSON P.S. #16043
 - 1973 LAND CORNER RECORDATION CERTIFICATE LIBER 002, PAGE 269 ELRICH P.S. #18986
 - 1974 RECORDED SURVEY LIBER 002, PAGE 981 FOUND 1/2" IRON ROD KAY P.S. #14096
- B. Description of corner evidence found and/or method applied in restoring or reestablishing corner: (CONTINUED ON BACK)

1993 NOV. ELRICH P.S. #18986 FOUND P.K. NAIL ON CENTERLINE OF MILLVILLE ROAD
 FOUND THREE WITNESS TIES FROM PREVIOUS SURVEYS THAT CHECKED THE CORNER AS SET IN 1971
 ACCEPTED P.K. NAIL AS BEST EVIDENCE OF ORIGINAL POSITION OF EAST CORNER OF SECTION 25

- C. Description of monument for corner and accessories established to perpetuate locating the position of the corner:
- M-10 1/2" IRON ROD WITH REMONUMENTATION CAP IN MONUMENT BOX
 - NORTH 11.02 FEET FOUND P.K. NAIL, USED AS WEST 1/4 CORNER OF SECTION 30, MAYFIELD TOWNSHIP
 - SOUTH 50° WEST 69.09 FEET SET NAIL & REMONUMENTATION TAG IN QUAD 6" BIRCH
 - SOUTH 20° WEST 83.33 FEET SET NAIL & REMONUMENTATION TAG IN POWER POLE
 - SOUTH 20° EAST 136.35 FEET SET NAIL & REMONUMENTATION TAG IN MICHIGAN BELL RISER POLE
 - SOUTH 30° EAST 56.10 FEET SET NAIL & REMONUMENTATION TAG IN RAILROAD TIE FENCE POST

Signed by Harold N. Elrich
 Surveyor's Michigan License No. 18986

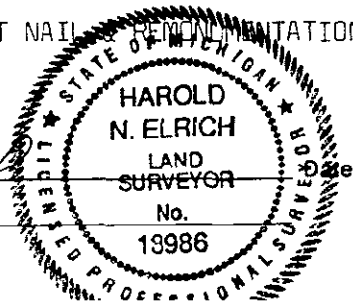

A.1974 RECORDED SURVEY LIBER 003, PAGE 100 FOUND 1/2" IRON ROD BATES P.S.#16699
1975 RECORDED SURVEY LIBER 003, PAGE 263 FOUND 1/2" IRON ROD HENDERSON P.S.#16043
1989 RECORDED SURVEY LIBER 008, PAGE 226 FOUND 1/2" IRON ROD GRAVLIN P.S. #23510
1989 RECORDED SURVEY LIBER 002, PAGE 269 FOUND 1/2" IRON ROD BATES P.S. #16699

MISC D 9.00
REMLC P0075
REMOHT 2.00