

1993

RECEIVED FOR RECORD

93 DEC 22 PM 2:49

COMMISSION

REMONUMENTATION LAND CORNER RECORDATION CERTIFICATE Filing Requirement of Act 74, Mich. P.A. 1970

LIBER NO. 5 - 16-17

For corners in

Lapeer (County)

Located In:

Corner Code #

- 1. Public Land Survey T 8NR 9E M-11
2. Property Controlling in Section S T R
3. Miscellaneous Property in Sec. S T R
4. Lot No. , Recorded Plat
5. Private Claims

Register of Deeds Stamp & File-Number

Grid table with columns A-M and rows 2-13, containing numbers 1-36.

I, HAROLD N. ELRICH, in a field survey on NOVEMBER, 19 93, do hereby certify that under requirements of P.A. 74, Michigan P.A. of 1970, the corner points mentioned in lines 1 and 2 above were in conformance with regulations and rules therefore as required in the current manual of survey instructions of the United States Department of the Interior, Bureau of Land Management or by a decree of a Court of Law and/or that the corner points mentioned in lines 3, 4 and 5 above were in conformance with the rules of the Michigan Board of Land Surveyors or by a Decree of a Court of Law; established, re-established, monumented, re-monumented, recovered, found as expressed below:

NOTE: Not more than 4 corners, all in the same town and range, may be recorded on this certificate.

A. Description of original monument and accessories and/or subsequent restoration:

- ORIGINAL GLO SURVEY BY JOS. WAMPLER D.S. SET POST WHITE OAK 20" NORTH 9 1/2° WEST 18 LINKS & IRONWOOD 8" SOUTH 49 1/2° WEST 9 LINKS
1974 RECORDED SURVEY LIBER 002, PAGE 961 FOUND 1/2" IRON ROD KAY P.S. #14096
1974 RECORDED SURVEY LIBER 003, PAGE 100 FOUND 1/2" IRON ROD BATES P.S. #16699
1975 RECORDED SURVEY LIBER 003, PAGE 263 FOUND 1/2" IRON ROD HENDERSON P.S.#16043
1978 RECORDED SURVEY LIBER 004, PAGE 518 CORNER NOT IDENTIFIED HENDERSON P.S.#16043
1989 RECORDED SURVEY LIBER 008, PAGE 350 1/2" IRON ROD IN MONUMENT BOX ELRICH #18986

B. Description of corner evidence found and/or method applied in restoring or reestablishing corner: CONTINUED ON BACK "A"

1993 NOV. ELRICH P.S. #18986 FOUND 1/2" IRON ROD BENT OVER IN "U" IN MONUMENT BOX AT CENTERLINE OF MICEVILLE ROAD, 14 FEET SOUTH OF DAVIS LAKE ROAD
WITNESSES TO WEST SIDE OF "U" MATCH PREVIOUS SURVEY AND LAND CORNER RECORDATION CERTIFICATE RECORDED IN 1989. MEASUREMENT FROM EAST 1/4 CORNER OF SECTION 36 TO NORTHEAST CORNER OF SECTION 36 WAS FOUND TO BE 2648.72 FEET IN 1978 AND 2649.00 FEET IN 1992.

ACCEPTED WEST SIDE OF IRON IN MONUMENT BOX AS BEST EVIDENCE OF ORIGINAL POSITION OF NORTHEAST CORNER OF SECTION 36 (M-11)

C. Description of monument for corner and accessories established to perpetuate locating the position of the corner:


- M-11 1/2" IRON ROD WITH REMONUMENTATION CAP IN MONUMENT BOX
NORTH 70° WEST 116.71 FEET SET NAIL & REMONUMENTATION TAG IN POWER POLE
NORTH 45° EAST 66.00 FEET SET NAIL & REMONUMENTATION TAG IN LIGHT POLE
SOUTH 65° WEST 134.43 FEET SET NAIL & REMONUMENTATION TAG IN POWER POLE
SOUTH 25° EAST 108.00 FEET SET NAIL & REMONUMENTATION TAG IN POWER POLE

Signed by

Harold N. Elrich

Surveyor's Michigan License No.

18986

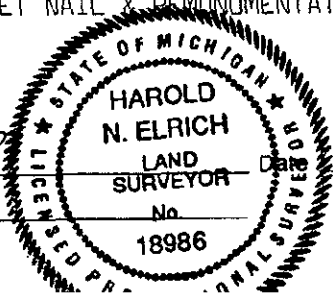

12-1-93

"A" 1989 LAND CORNER RECORDATION CERTIFICATE LIBER 004, PAGE 267
1/2" IRON IN MONUMENT BOX ELRICH P.S. #18986

1992 RECORDED SURVEY LIBER 009, PAGE 662 CORNER NOT IDENTIFIED
GRAVLIN P.S. #23510

1993 RECORDED SURVEY LIBER 010, PAGE 003 FOUND P.K. NAIL GRAVLIN P.S. #23510

1993 RECORDED SURVEY LIBER 010, PAGE 007 FOUND P.K. NAIL GRAVLIN P.S. #23510

MISC D	9.00
REMLC	P0075
REMOVT	2.00