

**SURVEY &
REMONUMENTATION**

1993

COMMISSION

**REMONUMENTATION
LAND CORNER RECORDATION CERTIFICATE
Filing Requirement of Act 74, Mich. P.A. 1970**

RECEIVED FOR RECORD

93 DEC 22 PM 2:50

LIBER 5 18-19
HAROLD N. ELRICH
LAND SURVEYOR
LAPEER MICHIGAN

For corners in

LAPEER
(County)

Located in:

Corner Code ##

- 1. Public Land Survey T 8N R 9E M-12
T R
T R
T R
- 2. Property Controlling S T R
in Section S T R
- 3. Miscellaneous S T R
Property in Sec. S T R
- 4. Lot No. , Recorded Plat
- 5. Private Claims

Register of Deeds Stamp & File Number

	A	B	C	D	E	F	G	H	I	J	K	L	M
2	6	5	4	3	2	1							
3													
4	7	8	9	10	11	12							
5													
6	18	17	16	15	14	13							
7													
8	19	20	21	22	23	24							
9													
10	30	29	28	27	26	25							
11													
12	31	32	33	34	35	36							
13													

I, HAROLD N. ELRICH, in a field survey on NOVEMBER, 19 93, do hereby certify that under requirements of P.A. 74, Michigan P.A. of 1970, the corner points mentioned in lines 1 and 2 above were in conformance with regulations and rules therefore as required in the current manual of survey instructions of the United States Department of the Interior, Bureau of Land Management or by a decree of a Court of Law and/or that the corner points mentioned in lines 3, 4 and 5 above were in conformance with the rules of the Michigan Board of Land Surveyors or by a Decree of a Court of Law; established, re-established, monumented, re-monumented, recovered, found as expressed below:

NOTE: Not more than 4 corners, all in the same town and range, may be recorded on this certificate.

A. Description of original monument and accessories and/or subsequent restoration:

ORIGINAL GLO SURVEY BY JOS. WAMPLER D.S. SET 1/2 MILE POST
SUGAR 5" NORTH 53 1/2° WEST 16 LINKS & SUGAR 8" SOUTH 16° WEST 42 LINKS

- 1977 RECORDED SURVEY LIBER 004, PAGE 696 SET P.K. NAIL ELRICH P.S. #18986
- 1977 RECORDED SURVEY LIBER 004, PAGE 410 CORNER NOT IDENTIFIED HENDERSON P.S. #16043
- 1977 RECORDED SURVEY LIBER 004, PAGE 411 CORNER NOT IDENTIFIED HENDERSON P.S. #16043
- 1978 RECORDED SURVEY LIBER 004, PAGE 518 FOUND P.K. NAIL HENDERSON P.S. #16043
- 1978 RECORDED SURVEY LIBER 004, PAGE 637 FOUND P.K. NAIL HENDERSON P.S. #16043

B. Description of corner evidence found and/or method applied in restoring or reestablishing corner:

NOV. 1993 ELRICH P.S. #18986 FOUND 1/2 IRON ROD IN MONUMENT BOX AT CENTERLINE/
CENTERLINE INTERSECTION OF REAMER ROAD & MILLVILLE ROAD

ONE WITNESS MATCHED ALL PREVIOUS SURVEYS. THE DISTANCE FROM THE CENTER OF SECTION 36 TO THE EAST 1/4 CORNER OF SECTION 36, MEASURED 2648.81 FEET TO A P.K. NAIL IN 1977 AND 2648.81 FEET TO THE IRON IN A MONUMENT BOX IN 1992

AS THERE IS CONSISTENT MEASUREMENTS NORTH & SOUTH & EAST & WEST FROM 1977 TO 1992, ACCEPTED THE IRON IN THE MONUMENT BOX AS THE BEST EVIDENCE OF THE ORIGINAL POSITION


C. Description of monument for corner and accessories established to perpetuate locating the position of the corner:

M-12 1/2" IRON ROD WITH REMONUMENTATION CAP IN MONUMENT BOX

- NORTH 50° WEST 64.24 FEET 14" WILLOW SET NAIL & REMONUMENTATION TAG
- NORTH 20° EAST 78.74 FEET 20" ASH SET NAIL & REMONUMENTATION TAG
- SOUTH 35° EAST 71.62 FEET 15" HICKORY SET NAIL & REMONUMENTATION TAG
- SOUTH 15° WEST 138.51 FEET 30" OAK SET NAIL & REMONUMENTATION TAG

Signed by Harold N. Elrich

Surveyor's Michigan License No. 18986

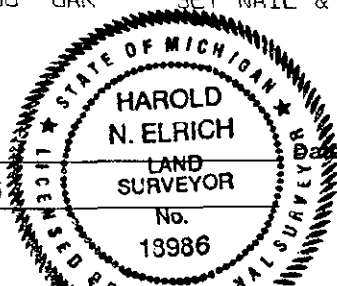

12-1-93

A. 1978 LAND CORNER RECORDATION CERTIFICATION LIBER 003, PAGE 435
RE-ESTABLISHED CORNER FROM PLAT OF
"SMITHFIELD SUBDIVISION", RECORDED
IN LIBER 3, PAGE 25, LAPEER COUNTY
RECORDS

WITNESSES MATCH PREVIOUS SURVEY

1980 RECORDED SURVEY LIBER 004, PAGE 636 CORNER NOT IDENTIFIED HENDERSON P.S.
1992 RECORDED SURVEY LIBER 009, PAGE 662 P.K. NAIL GRAVLIN P.S. #23510 #16043
1992 RECORDED SURVEY LIBER 009, PAGE 838 FOUND IRON ROD IN MONUMENT BOX
BAILEY P.S. #33968
1993 RECORDED SURVEY LIBER 010, PAGE 030 FOUND P.K. NAIL GRAVLIN P.S. #23510

MISC D 9.00
REMLC P0075
REMOHT 2.00