

SURVEY &
REMONUMENTATION

1993

COMMISSION

REMONUMENTATION
LAND CORNER RECORDATION CERTIFICATE
Filing Requirement of Act 74, Mich. P.A. 1970

RECEIVED FOR RECORD

93 DEC 22 PM 2:51

LIBER NO. 5 PAGE NO. 20

Melissa Miles
REGISTER OF DEEDS
LAPEER COUNTY, MICHIGAN

For corners in

LAPEER
(County)

Located In:

Corner Code #

- | | | | | | |
|------------------------------------|---|-----------|---|-----------|-------------|
| 1. Public Land Survey | T | <u>8N</u> | R | <u>9E</u> | <u>M-13</u> |
| | T | | R | | |
| | T | | R | | |
| | T | | R | | |
| 2. Property Controlling in Section | S | | T | R | |
| | S | | T | R | |
| 3. Miscellaneous Property in Sec. | S | | T | R | |
| | S | | T | R | |
4. Lot No. _____, Recorded Plat _____
5. Private Claims _____

Register of Deeds Stamp & File Number

I, HAROLD N. ELRICH, in a field survey on NOVEMBER, 19 93, do hereby certify that under requirements of P.A. 74, Michigan P.A. of 1970, the corner points mentioned in lines 1 and 2 above were in conformance with regulations and rules therefore as required in the current manual of survey instructions of the United States Department of the Interior, Bureau of Land Management or by a decree of a Court of Law and/or that the corner points mentioned in lines 3, 4 and 5 above were in conformance with the rules of the Michigan Board of Land Surveyors or by a Decree of a Court of Law; established, re-established, monumented, re-monumented, recovered, found as expressed below:

NOTE: Not more than 4 corners, all in the same town and range, may be recorded on this certificate.

	A	B	C	D	E	F	G	H	I	J	K	L	M
2	6	5		4	3		2		1				
3													
4	7	8		9	10		11		12				
5													
6	18	17		16	15		14		13				
7													
8	19	20		21	22		23		24				
9													
10	30	29		28	27		26		25				
11													
12	31	32		33	34		35		36				
13													


A. Description of original monument and accessories and/or subsequent restoration:
 ORIGINAL GLO SURVEY BY JOS. WAMPLER D.S. SET POST
 WHITE OAK 24" NORTH 56° WEST 45 LINKS & BLACK OAK 20" SOUTH 59 1/2° EAST 20 LINKS
 1987 RECORDED SURVEY LIBER 007, PAGE 781, FOUND IRON ROD IN MONUMENT BOX ELRICH P.S.#18986
 1988 RECORDED SURVEY LIBER 009, PAGE 838, FOUND IRON ROD IN MONUMENT BOX BAILEY P.S.#33968

B. Description of corner evidence found and/or method applied in restoring or reestablishing corner:
 NOV 1993 FOUND 1/2" IRON ROD IN MONUMENT BOX, ELRICH P.S. #18986
 MONUMENT BOX AT CENTERLINE/CENTERLINE OF OREGON & MILLVILLE ROADS
 FOUND TWO WITNESSES FROM 1987 SURVEY THAT CONFIRMS PRESENT LOCATION
 FOUND THREE WITNESSES FROM 1992 SURVEY THAT CONFIRMS PRESENT LOCATION
 ACCEPTED IRON ROD IN MONUMENT BOX AS BEST EVIDENCE OF ORIGINAL LOCATION
 OF SOUTHEAST CORNER OF SECTION 36

C. Description of monument for corner and accessories established to perpetuate locating the position of the corner:

M-13 1/2" IRON ROD WITH REMONUMENTATION CAP IN MONUMENT BOX
 NORTH 40° WEST 74.78 FEET POWER POLE
 NORTH 45° EAST 59.43 FEET POWER POLE
 SOUTH 35° EAST 108.10 FEET POWER POLE
 SOUTH 45° WEST 46.70 FEET BRACE POLE

Signed by Harold N. Elrich
 Surveyor's Michigan License No. 18986

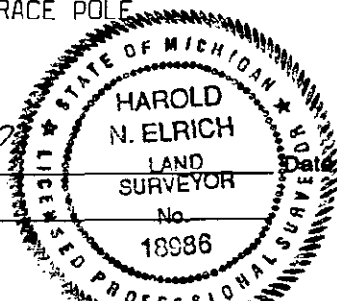

12-1-93