MAYFIELD
T8N-R10E
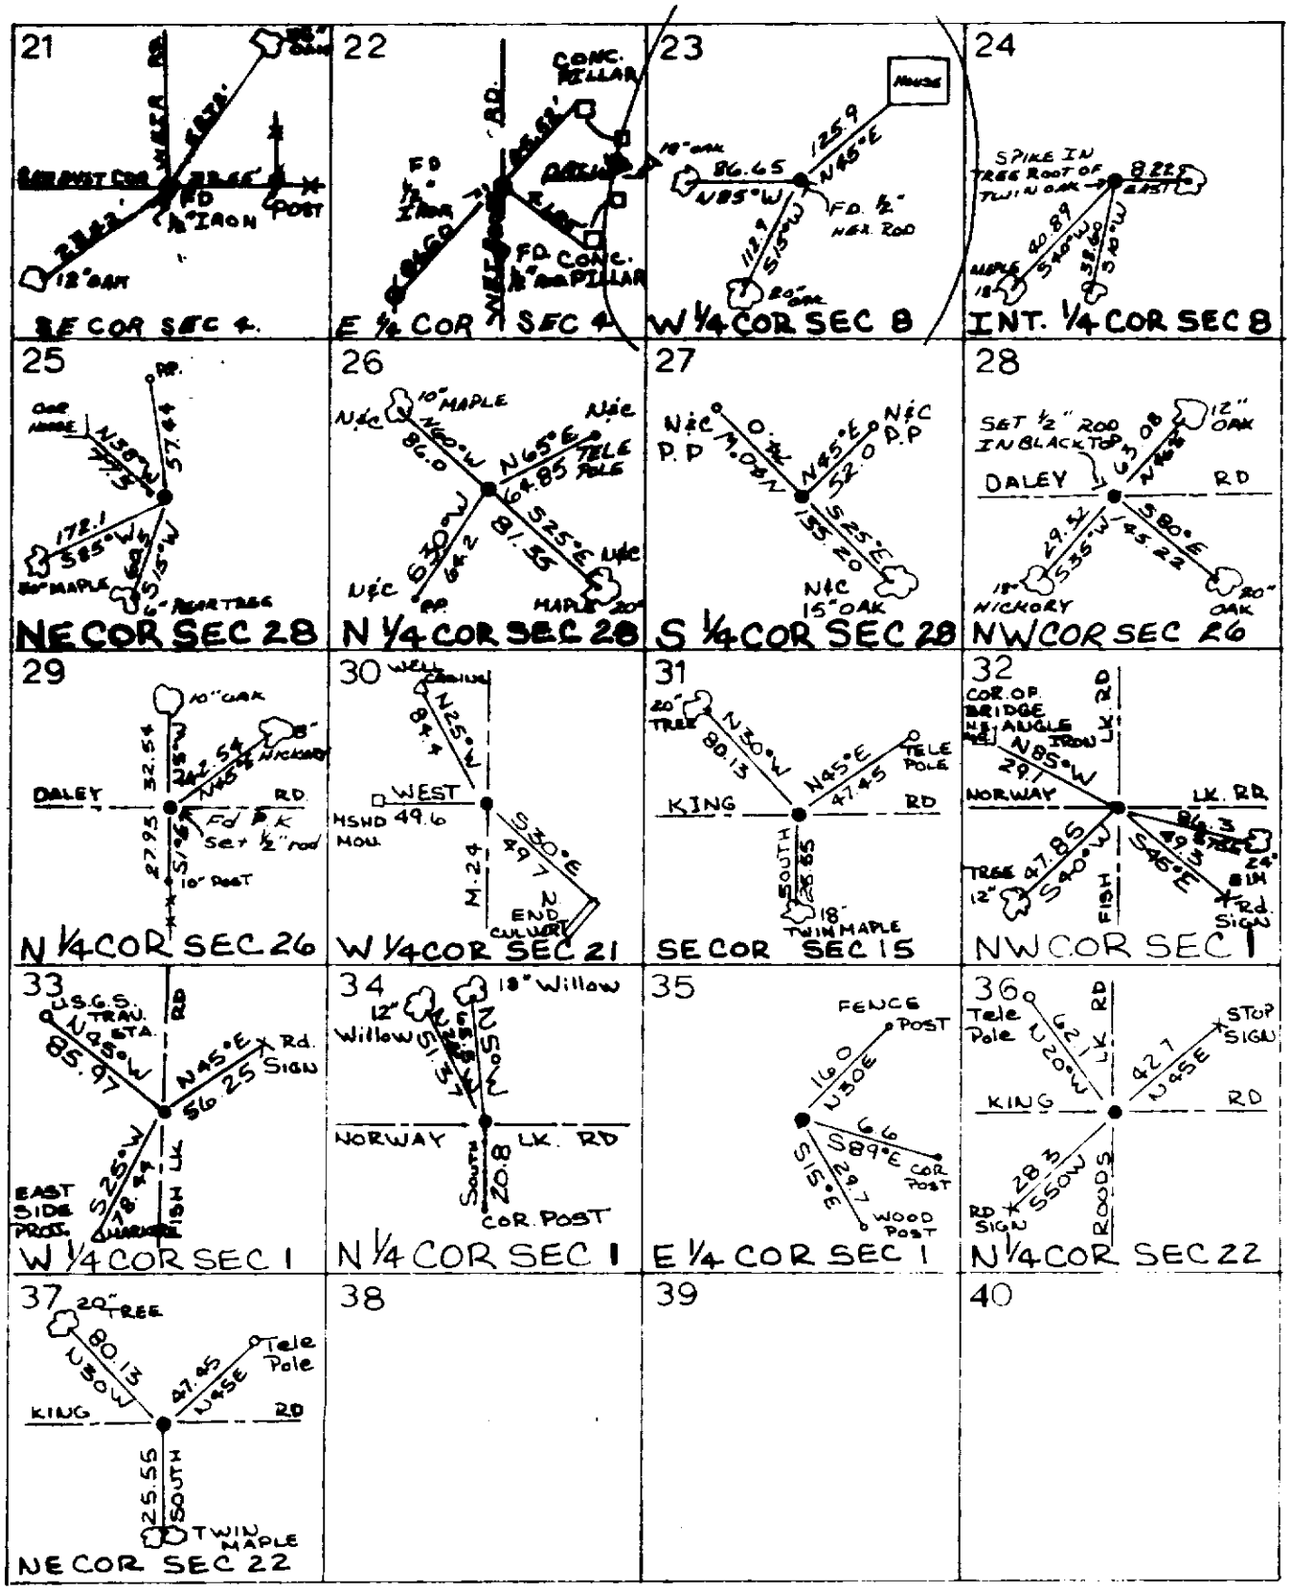
LAPEER