

SURVEY & REMONUMENTATION

MAR 13 1998

REMONUMENTATION LAND CORNER RECORDATION CERTIFICATE Filing Requirement of Act 74, Mich. P.A. 1970

RECEIVED RECORD
98 FEB 26 PM 3:21

SECTION

For corners in

LAPEER

(County)

Located In:

Corner Code ##

Public Land Survey	T <u>8N</u> R <u>10E</u>	<u>A-12</u>
	T _____ R _____	_____
	T _____ R _____	_____
	T _____ R _____	_____
2 Property Controlling in Section	S _____ T _____ R _____	_____
	S _____ T _____ R _____	_____
3 Miscellaneous Property in Sec.	S _____ T _____ R _____	_____
	S _____ T _____ R _____	_____

Register of Deeds Stamp & File Number

4 Lot No. _____ Recorded Plat _____
5 Private Claims _____

	A	B	C	D	E	F	G	H	I	J	K	L	M
2	6	5	4	3	2	1							
3													
4	7	8	9	10	11	12							
5													
6	18	17	16	15	14	13							
7													
8	19	20	21	22	23	24							
9													
10	30	29	28	27	26	25							
11													
12	31	32	33	34	35	36							
13													

MICHAEL G. HAY in a field survey on AUGUST, 19 97, do hereby certify that under requirements of P.A. 74, Michigan P.A. of 1970, the corner points mentioned in lines 1 and 2 above were in conformance with regulations and rules therefore as required in the current manual of survey instructions of the United States Department of the Interior, Bureau of Land Management or by a decree of a Court of Law and/or that the corner points mentioned in lines 3, 4 and 5 above were in conformance with the rules of the Michigan Board of Land Surveyors or by a Decree of a Court of Law, established, re-established, monumented, re-monumented, recovered, found as expressed below:

NOTE: Not more than 4 corners, all in the same town and range, may be recorded on this certificate.

- A. Description of original monument and accessories and/or subsequent restoration:
- 1822 Joseph Wampler D.S. No corner set
 - 1875 Gilbert Bates 20 8 6 Brick, Drag tooth, Small stones Elm 12 S26E 157 School House N40 1/2E 74
 - 1981 Harold N. Elrich PS # 18986 L6, P105 surveys Found p.k. nail S45 W 53.82' T. Pole N40 E 79.31' 22" Ash S35E 71.70' 14" hickory.
 - 1981 Harold N. Elrich PS # 18986 L6, P285 surveys Found p.k. nail Witnesses the same.
 - 1984 Harold N. Elrich PS # 18986 L 6, P710 surveys Same witnesses (no desc.)
 - 1990 Carl M. Carlson PS # 9189 L 8, P 762 surveys Found p.k. nail Witnesses the same
 - 1993 Harold N. Elrich PS # 18986 Remonumentation of M-12, T8N, R9E, Oregon Township has surveys with same witnesses.


B. Description of corner evidence found and/or method applied in restoring or reestablishing corner:

1997 Michael G. Hay PS 41101 Found Remonumentation cap in monument box in the centerline of Millville (N-S) and Reamer (West) Roads and tree line running to the East behind houses. Recovered one witness.
Recovered one witness from surveys. Recovered all witnesses from Remonumentation.

A-12 to A-13 2639.84'
A-11 to A-11 2048.92'

C. Description of monument for corner and accessories established to perpetuate locating the position of the corner:

A-12 Remonumentation cap in monument box
N50W 64.24 Nail and Remonumentation tag 14" Willow
N20E 78.74' Nail and Remonumentation tag in 20" Ash
S35E 71.62' Nail and Remonumentation tag in 15" Hickory
S15W 138.51' Nail and Remonumentation tag in 30" Oak

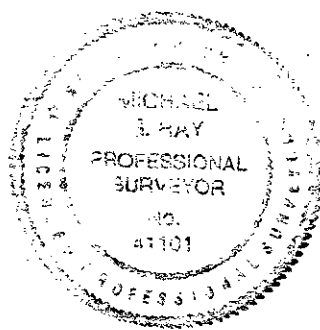

Signed by Michael G. Hay Date September 26, 1997
Surveyor's Michigan License No. 41101