

**SURVEY &
REMONUMENTATION**

MAR 13 1998


SECTION

**REMONUMENTATION
LAND CORNER RECORDATION CERTIFICATE
Filing Requirement of Act 74, Mich. P.A. 1970**

RECEIVED FOR RECORD
98 FEB 26 PM 3:22

For corners in
Lapeer
(County)

1. Public Land Survey	T <u>8N</u> R <u>10E</u>	<u>A-13</u>
	T _____ R _____	_____
	T _____ R _____	_____
	T _____ R _____	_____
2. Property Controlling in Section	S _____ T _____ R _____	_____
	S _____ T _____ R _____	_____
3. Miscellaneous Property in Sec.	S _____ T _____ R _____	_____
	S _____ T _____ R _____	_____
4. Lot No. _____, Recorded Plat _____		
5. Private Claims _____		

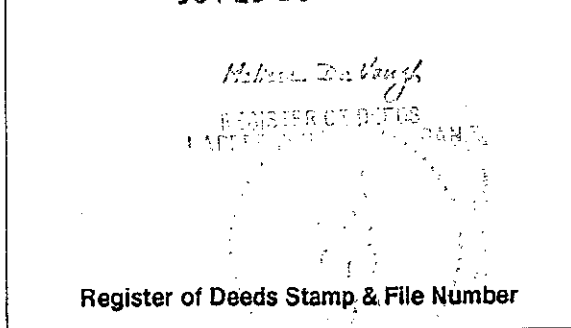

I, MICHAEL G. HAY, in a field survey on AUGUST, 19 97, do hereby certify that under requirements of P.A. 74, Michigan P.A. of 1970, the corner points mentioned in lines 1 and 2 above were in conformance with regulations and rules therefore as required in the current manual of survey instructions of the United States Department of the Interior, Bureau of Land Management or by a decree of a Court of Law and/or that the corner points mentioned in lines 3, 4 and 5 above were in conformance with the rules of the Michigan Board of Land Surveyors or by a Decree of a Court of Law; established, re-established, monumented, re-monumented, recovered, found as expressed below:

	A	B	C	D	E	F	G	H	I	J	K	L	M
2	6	5	4	3	2	1							
3													
4	7	8	9	10	11	12							
5													
6	18	17	16	15	14	13							
7													
8	19	20	21	22	23	24							
9													
10	30	29	28	27	26	25							
11													
12	31	32	33	34	35	36							
13													

NOTE: Not more than 4 corners, all in the same town and range, may be recorded on this certificate.

A. Description of original monument and accessories and/or subsequent restoration:

- 1850 Joseph Wampler D.S. Set post - White oak 24 N56W 45, Black Oak 20 S591/2E 20
- 1990 Carl M. Carlson PS # 9189 L8, P 762 surveys Corner description not mentioned or witnesses
- 1991 Leland D. Bates PS # 16699 L9, P491 surveys N45W 74.40' T. Pole S45W 47.80' P. Pole S45E 108.10' P. Pole.
- 1993 Harold N. Elrich PS # 18986 Remonumentation recordation for Section 36, T8N, R9E, M-13.

B. Description of corner evidence found and/or method applied in restoring or reestablishing corner:


1997 Michael G. Hay PS # 41101 found Remonumentation cap in mon box in the centerline of Millville (N-S) and Oregon (E-W) Roads in good condition. Witnesses of 1991 of Leland D. Bates match witnesses of surveys recorded in the Remonumentation of M-13 T8N, R9E, Oregon Township making the corner common.

A-13 to A-12 2639.84' (m)
A-13 to B-13 2078.60' (m)

Signature: Michael G. Hay
Date: 10-13-97

C. Description of monument for corner and accessories established to perpetuate locating the position of the corner:

- A-13 1/2" iron with Remonumentation cap in monument box
- N 40 W 74.78' Power Pole
- N 45 E 59.43' Power Pole
- S 35 E 108.10' Power Pole
- S 45 W 46.70" Brace Pole

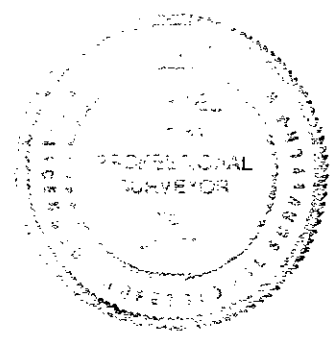

Signed by Michael G. Hay Date September 26, 1997
Surveyor's Michigan License No. 41101