

**SURVEY & REMONUMENTATION**

MAY 28 1997

COMMISSION

**REMONUMENTATION  
LAND CORNER RECORDATION CERTIFICATE  
Filing Requirement of Act 74, Mich. P.A. 1970**

RECEIVED FOR RECORD  
97 JAN 13 PM 2:49

For corners in

<u>LAPEER</u> (County)	Located In:	Corner Code #
1. Public Land Survey MAYFIELD TOWNSHIP	T <u>8N</u> R <u>10E</u>	<u>K-2</u>
	T _____ R _____	_____
	T _____ R _____	_____
	T _____ R _____	_____
2. Property Controlling in Section	S _____ T _____ R _____	_____
	S _____ T _____ R _____	_____
3. Miscellaneous Property in Sec.	S _____ T _____ R _____	_____
	S _____ T _____ R _____	_____

*Melissa DeVaugh*  
REGISTER OF DEEDS  
LAPEER COUNTY, MICHIGAN

Register of Deeds Stamp & File Number

4. Lot No. \_\_\_\_\_, Recorded Plat \_\_\_\_\_  
5. Private Claims \_\_\_\_\_

	A	B	C	D	E	F	G	H	I	J	K	L	M
2	6	5	4	3	2	1							
3													
4	7	8	9	10	11	12							
5													
6	18	17	16	15	14	13							
7													
8	19	20	21	22	23	24							
9													
10	30	29	28	27	26	25							
11													
12	31	32	33	34	35	36							
13													

I, HAROLD N. ELRICH, in a field survey on APRIL 11, 1996, do hereby certify that under requirements of P.A. 74, Michigan P.A. of 1970, the corner points mentioned in lines 1 and 2 above were in conformance with regulations and rules therefore as required in the current manual of survey instructions of the United States Department of the Interior, Bureau of Land Management or by a decree of a Court of Law and/or that the corner points mentioned in lines 3, 4 and 5 above were in conformance with the rules of the Michigan Board of Land Surveyors or by a Decree of a Court of Law; established, re-established, monumented, re-monumented, recovered, found as expressed below.

**NOTE: Not more than 4 corners, all in the same town and range, may be recorded on this certificate.**

**A. Description of original monument and accessories and/or subsequent restoration:**

- 1824 S. SIBLEY SET 1/2 MILE POST - B ASH 11 S 6° E 8, PINE 20 N 32½° W 8
- 1869 GILBERT BATES - STAKE - WHITE OAK 30 N 56° W 63
- 1971 KAY ENGINEERING (UNRECORDED - NO WITNESSES)
- 1974 BERNARD HENDERSON P.S. #16043, LIBER 002, PAGE 653, FOUND IRON STAKE - N 45° E 56.25 FEET ROAD SIGN, S 25° W 78.44 FEET PROJECT MARKER, N 45° W 85.97 FEET USGS MONUMENT
- 1980 CHARLES S. GETZ P.S. #25843 LIBER 006, PAGE 196, FOUND MONUMENT BOX-N 45° E 56.25 FEET ROAD SIGN, S 25° W 78.44 FEET PROJECT MARKER, N 45° W 85.97 FEET USGS MONUMENT
- 1982 EARL E. GRAVLIN P.S. #23510, LIBER 006, PAGE 261- FOUND IRON IN MONUMENT BOX (SAME WITNESSES AS PREVIOUS SURVEYS) SEE BACK

**B. Description of corner evidence found and/or method applied in restoring or reestablishing corner:**

1996 HAROLD N. ELRICH P.S. #18986 FOUND 5/8" IRON IN MONUMENT BOX AT CENTERLINE OF FISH LAKE ROAD AND KINGS MILL ROAD. FOUND FOUR WITNESSES FROM PREVIOUS SURVEYS AND LAND CORNER RECORDATION CERTIFICATE THAT LOCATE THE 5/8" IRON FOUND.

ACCEPTED 5/8" IRON IN MONUMENT BOX AS BEST LOCATION OF ORIGINAL POSITION OF WEST 1/4 CORNER OF SECTION 1, T8N-R10E, MAYFIELD TOWNSHIP, LAPEER COUNTY, MICHIGAN


MEASURED REFERENCES - K-2 TO K-1 2907.83 FEET  
K-2 TO J-2 2643.67 FEET  
K-2 TO K-3 2663.66 FEET

**C. Description of monument for corner and accessories established to perpetuate locating the position of the corner:**

K-2 PLACED LAPEER COUNTY REMONUMENTATION CAP ON 5/8" IRON FOUND

SET NEW WITNESSES - N 55° W 89.92 FEET P.K. NAIL & WASHER IN UTILITY POLE  
N 30° W 60.96 FEET P.K. NAIL & WASHER IN UTILITY POLE  
S 27° E 75.21 FEET P.K. NAIL & WASHER IN 6" POPLAR  
S 65° W 88.06 FEET P.K. NAIL & WASHER IN UTILITY POLE

Signed by Harold N. Elrich  
Surveyor's Michigan License No. \_\_\_\_\_

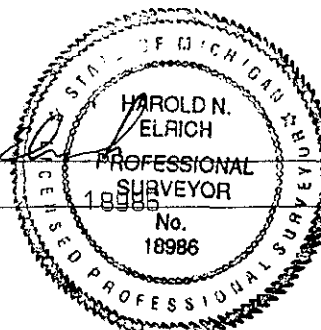

Date 12-30-96

FORM APPROVED BY MICHIGAN STATE BOARD OF LAND SURVEYORS, JAN. 28, 1971  
REVISED MAY 14, 1975  
REVISED JAN., 1983

LIBER 0005 PAGE 0399

SURVEY &  
REMONUMENTATION

MAY 28 1997

COMMISSION

- 1984 HAROLD N. ELRICH P.S. #18986 FOUND 1/2" IRON ROD IN MONUMENT BOX (NO WITNESSES SHOWN ON SURVEY) LIBER 006, PAGE 812
- 1985 HAROLD N. ELRICH P.S. #18986 FOUND 1/2" IRON IN MONUMENT BOX N 45° E 56.25 FEET ROAD SIGN, S 25 ° W 78.44 FEET PROJECT MARKER, N 45 ° W 85.97 FEET USGS MONUMENT, LIBER 006, PAGE 918
- 1986 HAROLD N. ELRICH P.S. #18986 FOUND 1/2" IRON IN MONUMENT BOX (NO WITNESSES SHOWN ON SURVEY) LIBER 007, PAGE 466
- 1987 LELAND D. BATES P.S. #16699 FOUND 1/2" IRON IN MONUMENT BOX (NO WITNESSES SHOWN ON SURVEY) LIBER 007, PAGE 497
- 1988 HAROLD N. ELRICH P.S. #18986 FOUND 1/2" IRON ROD IN MONUMENT BOX - N 45° W 86.16 FEET USGS MONUMENT, N 45° W 90.05 FEET SPIKE IN POWER POLE, S 50° W 81.75 FEET SPIKE IN ANCHOR POLE, N 70° E 65.43 FEET STOP SIGN LIBER 008, PAGE 188
- 1989 HAROLD N. ELRICH P.S. #18986 LAND CORNER RECORDATION CERTIFICATE FOUND 1/2" IRON IN MONUMENT BOX (SAME WITNESSES AS PREVIOUS SURVEY) LIBER 004, PAGE 211
- 1992 HAROLD N. ELRICH P.S. #18986 FOUND 5/8" IRON IN MONUMENT BOX N 45° W 90.00 FEET NAIL IN POWER POLE, S 65° W 81.65 FEET NAIL IN ANCHOR POLE, N 35° E 61.00 FEET NAIL IN POWER POLE LIBER 009, PAGE 868

PEER GROUP  
APPROVED LAND CORNER  
PA 345 OF 1990  
LAPSEE COUNTY

*Ray Davis*  
RAY DAVIS S. CO. SURVEYOR  
DATE 8-27-96

MISC D 9.00  
REMLC P0075  
REMOHT 2.00