

SURVEY & REMONUMENTATION

REMONUMENTATION

RECEIVED FOR RECORD

MAR 28 2000 LAND CORNER RECORDATION CERTIFICATE
 Filing Requirement of Act 74, Mich. P.A. 1970

00 FEB 10 PH 2:19

Melissa DeVaugh
 REGISTER OF DEEDS
 LAPEER COUNTY, MICHIGAN

For corners in **SECTION**

LAPEER Located In: MAYFIELD TWP. Corner Code # _____
 (County)


1. Public Land Survey T 8 N R 10 E Corner Code # K-4
 T _____ R _____
 T _____ R _____
 T _____ R _____

2. Property Controlling S _____ T _____ R _____
 in Section S _____ T _____ R _____

3. Miscellaneous S _____ T _____ R _____
 Property in Sec. S _____ T _____ R _____

4. Lot No. _____ Recorded Plat _____

5. Private Claims _____

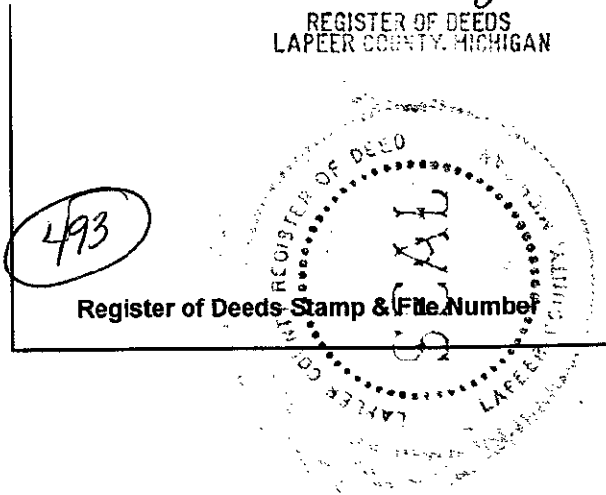

	A	B	C	D	E	F	G	H	I	J	K	L	M
1													
2	6	5	4	3	2	1							
3													
4	7	8	9	10	11	12							
5													
6	18	17	16	15	14	13							
7													
8	19	20	21	22	23	24							
9													
10	30	29	28	27	26	25							
11													
12	31	32	33	34	35	36							
13													

I, MICHAEL G. HAY, in a field survey on AUGUST 22, 1999, do hereby certify that under requirements of P.A. 74, Michigan P.A. of 1970, the corner points mentioned in lines 1 and 2 above were in conformance with regulations and rules therefore as required in the current manual of survey instructions of the United States Department of the Interior, Bureau of Land Management or by a decree of a Court of Law and/or that the corner points mentioned in lines 3, 4 and 5 above were in conformance with the rules of the Michigan Board of Land Surveyors or by a Decree of a Court of Law; established, re-established, monumented, re-monumented, recovered, found as expressed below:

NOTE: Not more than 4 corners, all in the same town and range, may be recorded on this certificate.

A. Description of original monument and accessories and/or subsequent restoration:

- 1822- JOSEPH WAMPLER D.S. SET 1/2 MILE POST
- 1866- GILBERT BATES C.S. STAKE
- 1978- ROBERT G. KAY P.S. 14096 (SURVEY) LIBER 4 PAGE 988 FOUND RAILROAD SPIKE
- 1982- HAROLD N. ELRICH P.S. 18986 (SURVEY) LIBER 6 PAGE 354 FND RAILROAD SPIKE IN MON BOX
- 1982- HAROLD N. ELRICH P.S. 18986 (LCRC) LIBER 9 PAGE 41 FND RAILROAD SPIKE IN MON BOX
- 1984- BERNARD HENDERSON P.S. 16043 (SURVEY) LIBER 6 PAGE 834 FND RAILROAD SPIKE IN MON BOX
- 1993- EARL E. GRAVLIN P.S. 23510 (SURVEY) LIBER 10 PAGE 445 FND R.R SPIKE MON BOX
- 1993- HAROLD N. ELRICH P.S. 18986 (SURVEY) LIBER 10 PAGE 403 FND SPIKE IN 4" POPLAR
- 1994- EARL E. GRAVLIN P.S. 23510 (SURVEY) LIBER 10 PAGES 593-594 FND MONUMENT BOX
- 1994- EARL E. GRAVLIN P.S. 23510 (SURVEY) LIBER 10 PAGE 768 FND RAILROAD SPIKE
- 1995- HAROLD N. ELRICH P.S. 18986 (SURVEY) LIBER 11 PAGE 213 FND RAILROAD SPIKE IN MON BOX

B. Description of corner evidence found and/or method applied in restoring or reestablishing corner:

- 1999-MICHAEL G. HAY P.S. 41101 FOUND RAILROAD SPIKE IN MONUMENT BOX ONE FOOT EAST OF CENTERLINE OF FISH LAKE ROAD (PAVED). TREE LINE WEST AND NO OCCUPATION EAST.
- | | | | | | | |
|-----|----|-----|-------------|-------------------|------------------------|----------------|
| K-4 | TO | K-3 | 2661.17'(M) | 2640.00' (40 GLO) | 2669.04'(40.44 COUNTY) | 2661.07' (HBE) |
| K-4 | TO | K-5 | 2654.01'(M) | 2640.00' (40 GLO) | 2653.98' (GRAVLIN) | |

C. Description of monument for corner and accessories established to perpetuate locating the position of the corner:

SET STANDARD REMONUMENTATION CAP ON 1/2" IRON IN MONUMENT BOX

- WEST 49.05' NAIL IN 24" POPLAR N. FACE
- S40W 58.04' NAIL IN 18" POPLAR NNW FACE
- S45E 85.27' NAIL IN 10" POPLAR E. FACE
- S85E 58.09' NAIL IN 8" POPLAR N. FACE

PEER GROUP
 APPROVED LAND CORNER
 PA 345 OF 1990
 LAPEER COUNTY

Ray Davis
 RAY DAVIS P.S. CO. SURVEYOR
 DATE 11-10-1999



Signed by Michael G. Hay Date 1-11-2000
 Surveyor's Michigan License No. 41101