

**SURVEY & REMONUMENTATION**

MAR 23 2000

SECTION

**REMONUMENTATION LAND CORNER RECORDATION CERTIFICATE**

Filing Requirement of Act 74, Mich. P.A. 1970

RECEIVED FOR RECORD  
00 FEB 10 PM 2:20

Melissa DeVaugh  
REGISTER OF DEEDS  
LAPEER COUNTY MICHIGAN

For corners in

LAPEER Located In: MAYFIELD TWP. Corner Code # K-5  
(County)


1. Public Land Survey T 8 N R 10 E  
T R  
T R  
T R

2. Property Controlling S T R  
in Section S T R

3. Miscellaneous S T R  
Property in Sec. S T R

4. Lot No. \_\_\_\_\_, Recorded Plat \_\_\_\_\_

5. Private Claims \_\_\_\_\_

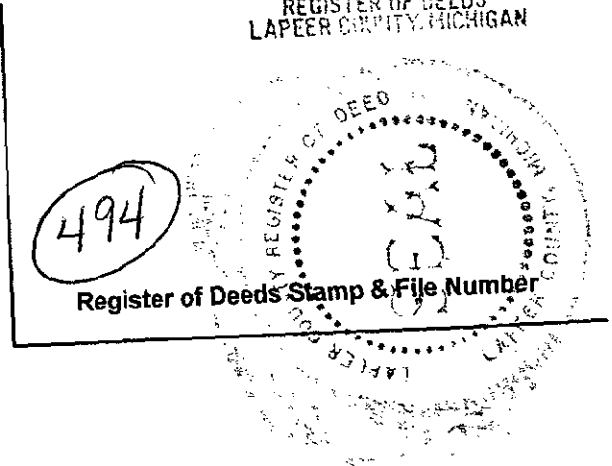

	A	B	C	D	E	F	G	H	I	J	K	L	M
1													
2	6	5	4	3	2	1							
3													
4	7	8	9	10	11	12							
5													
6	18	17	16	15	14	13							
7													
8	19	20	21	22	23	24							
9													
10	30	29	28	27	26	25							
11													
12	31	32	33	34	35	36							
13													

I, MICHAEL G. HAY, in a field survey on AUGUST 22, 1999, do hereby certify that under requirements of P.A. 74, Michigan P.A. of 1970, the corner points mentioned in lines 1 and 2 above were in conformance with regulations and rules therefore as required in the current manual of survey instructions of the United States Department of the Interior, Bureau of Land Management or by a decree of a Court of Law and/or that the corner points mentioned in lines 3, 4 and 5 above were in conformance with the rules of the Michigan Board of Land Surveyors or by a Decree of a Court of Law; established, re-established, monumented, re-monumented, recovered, found as expressed below:


**NOTE: Not more than 4 corners, all in the same town and range, may be recorded on this certificate.**

- A. Description of original monument and accessories and/or subsequent restoration:  
 1822- JOSEPH WAMPLER D.S. SET POST CORNER TO SECTION 11, 12, 13, & 14  
 1866- GILBERT BATES C.S. SET STAKE  
 1991- EARL E. GRAVLIN P.S. 23510 (SURVEY) LIBER 9 PAGE 316 FOUND NAIL  
 1994- EARL E. GRAVLIN P.S. 23510 (SURVEY) LIBER 10 PAGES 593-594 FOUND PK NAIL SET 1/2" IRON

- B. Description of corner evidence found and/or method applied in restoring or reestablishing corner:  
 1999-MICHAEL G. HAY P.S. 41101 FOUND 1/2" IRON CAP 23510 IN CENTERLINE OF FISH LAKE ROAD  
 (PAVED). TREE LINE RUNNING WEST AND FENCE LINE RUNNING EAST.  
 K-5 TO K-4 2654.01'(M) 2653.98' (GRAVLIN) 2640.00' (40 GLO)  
 K-5 TO K-6 2653.02'(M) 2640.00' (40 GLO)

- C. Description of monument for corner and accessories established to perpetuate locating the position of the corner:  
 SET STANDARD REMONUMENTATION CAP ON 1/2" IRON IN MON BOX  
 WEST 34.85' NAIL IN TOP 4x4 POST  
 S35W 48.38' NAIL IN TWIN 18" MAPLE  
 N45E 43.40' NAIL IN 16" OAK  
 S45E 56.95' NAIL AND ROWE WASHER IN 20" OAK

PEER GROUP  
APPROVED LAND CORNER  
PA 345 OF 1990  
LAPEER COUNTY  
RAY DAVIS P.S. CO. SURVEY  
DATE 11-10-1999

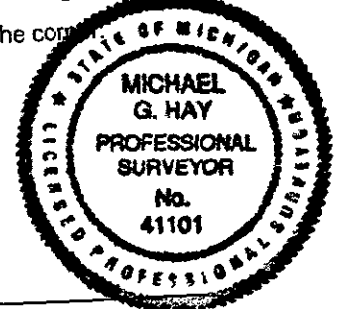

Signed by Michael G. Hay Date 1-11-2000  
 Surveyor's Michigan License No. 41101

FORM APPROVED BY MICHIGAN STATE BOARD OF LAND SURVEYORS, JAN. 28, 1971

REVISED MAY 14, 1975  
 REVISED JAN., 1983  
 ADAPTED FOR WORD PROCESSING MARCH, 1983