

SURVEY &
REMONUMENTATION

1993

COMMISSION

REMONUMENTATION
LAND CORNER RECORDATION CERTIFICATE
Filing Requirement of Act 74, Mich. P.A. 1970

RECEIVED FOR RECORD

93 DEC 22 PM 2:58

LIBER 5
L.A.P.E.E.R.
REGISTERED
L.A.P.E.E.R.

For corners in

L.A.P.E.E.R.
(County)

Located In:

Corner Code #

1. Public Land Survey T 8N R 10E M-12
 T _____ R _____
 T _____ R _____
 T _____ R _____
2. Property Controlling S _____ T _____ R _____
 in Section S _____ T _____ R _____
3. Miscellaneous S _____ T _____ R _____
 Property in Sec. S _____ T _____ R _____
4. Lot No. _____, Recorded Plat _____
5. Private Claims _____

Register of Deeds Stamp & File Number

	A	B	C	D	E	F	G	H	I	J	K	L	M
2	6	5	4	3	2	1							
3													
4	7	8	9	10	11	12							
5													
6	18	17	16	15	14	13							
7													
8	19	20	21	22	23	24							
9													
10	30	29	28	27	26	25							
11													
12	31	32	33	34	35	36							
13													

I, HAROLD N. ELRICH, in a field survey on NOVEMBER, 19 93, do hereby certify that under requirements of P.A. 74, Michigan P.A. of 1970, the corner points mentioned in lines 1 and 2 above were in conformance with regulations and rules therefore as required in the current manual of survey instructions of the United States Department of the Interior, Bureau of Land Management or by a decree of a Court of Law and/or that the corner points mentioned in lines 3, 4 and 5 above were in conformance with the rules of the Michigan Board of Land Surveyors or by a Decree of a Court of Law; established, re-established, monumented, re-monumented, recovered, found as expressed below:

NOTE: Not more than 4 corners, all in the same town and range, may be recorded on this certificate.

A. Description of original monument and accessories and/or subsequent restoration:

ORIGINAL GLO SURVEY BY JOS. WAMPLER D.S.
 ASPIN 11" CORNER TREE

1872 GILBERT BATES SET STONE 30" X 8" X 5" & SMALL STONES, STONE 30" X 18" X 3"
 AND SMALL STONES SOUTH 88° WEST 43 LINKS

1980 RECORDED SURVEY LIBER 005, PAGE 812 RESET CORNER FROM UNRECORDED SURVEY BY
 KAY P.S. #14096. SET 1/2" IRON ROD GRAVLIN P.S. #23510
 WITNESS TIES FROM 1980 SURVEY MATCH UNRECORDED SURVEY

1991 LAND CORNER RECORDATION CERTIFICATE LIBER 004, PAGE 368 FOUND 1/2" IRON ROD GRAVLIN
 P.S. #23510

B. Description of corner evidence found and/or method applied in restoring or reestablishing corner:

1993 NOV ELRICH P.S. #18986 FOUND 1/2" IRON ROD IN CENTERLINE OF FIVE LAKES ROAD

ALL FOUR WITNESS TIES MATCH 1980 SURVEY & 1991 LAND CORNER RECORDATION CERTIFICATE

ACCEPTED THE IRON ROD FOUND AS BEST EVIDENCE OF ORIGINAL POSITION OF EAST 1/4 CORNER
 OF SECTION 36

C. Description of monument for corner and accessories established to perpetuate locating the position of the corner:

M-12 1/2" IRON ROD WITH REMONUMENTATION CAP

3.53' NORTH TO IRON ROD USED AS WEST 1/4 CORNER OF SECTION 31, ARCADIA TOWNSHIP
 FROM RECORDED SURVEY LIBER 006, PAGE 72 PANGUS P.S. #21578

SOUTH 85° WEST 49.60 FEET NORTHEAST CORNER OF CHURCH

SOUTH 60° WEST 52.50 FEET EAST CORNER OF CONCRETE SLAB


SOUTH 30° WEST 81.40 FEET NAIL & REMONUMENTATION TAG IN POWER POLE

SOUTH 30° EAST 86.20 FEET NAIL & REMONUMENTATION TAG IN POWER POLE

Signed by Harold N. Elrich

Date 12-1-93

Surveyor's Michigan License No. 18986

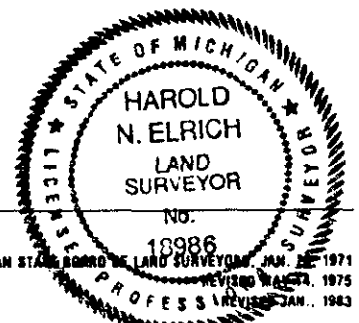

FORM APPROVED BY MICHIGAN STATE BOARD OF LAND SURVEYORS, JAN. 21, 1971
 REVISION W.A.L. 1975
 PROFESSIONAL SURVEYOR, JAN., 1983