

10-21
SURVEY &
REMONUMENTATION

REMONUMENTATION

MAR 23 2000

LAND CORNER RECORDATION CERTIFICATE

Filing Requirement of Act 74, Mich. P.A. 1970


SECTION

For corners in

RECEIVED FOR RECORD

99 DEC 14 AM 9:15

<u>Lapeer</u> (County)	Located In: Arcadia Twp.	Corner Code # <u>A-1</u>
1. Public Land Survey	T <u>8N</u> R <u>11E</u>	<u>A-1</u>
	T _____ R _____	_____
	T _____ R _____	_____
	T _____ R _____	_____
2. Property Controlling in Section	S _____ T _____ R _____	_____
	S _____ T _____ R _____	_____
3. Miscellaneous Property in Sec.	S _____ T _____ R _____	_____
	S _____ T _____ R _____	_____

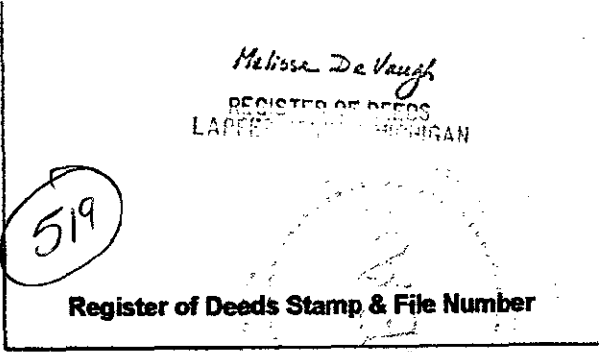

4. Lot No. _____, Recorded Plat _____
5. Private Claims _____

A B C D E F G H I J K L M

1												
2	6	5	4	3	2	1						
3												
4	7	8	9	10	11	12						
5												
6	18	17	16	15	14	13						
7												
8	19	20	21	22	23	24						
9												
10	30	29	28	27	26	25						
11												
12	31	32	33	34	35	36						
13												

I, Earl E. Gravlin, in a field survey on July 23 19 99, do hereby certify that under requirements of P.A. 74, Michigan P.A. of 1970, the corner points mentioned in lines 1 and 2 above were in conformance with regulations and rules therefore as required in the current manual of survey instructions of the United States Department of the Interior, Bureau of Land Management or by a decree of a Court of Law and/or that the corner points mentioned in lines 3, 4 and 5 above were in conformance with the rules of the Michigan Board of Land Surveyors or by a Decree of a Court of Law; established, re-established, monumented, re-monumented, recovered, found as expressed below.

NOTE: Not more than 4 corners, all in the same town and range, may be recorded on this certificate.

A. Description of original monument and accessories and/or subsequent restoration:
GLO: not set. County Surveyor: nothing. 1974 Kay job #74-123B, cor common to 4 adjacent twps, N30E 34.5' 24" maple, N01W 45.45' 10" maple. 1974 Kay L3 P 145-146, same as 1974 Kay. 1976 Kay L3 P880-881, same as 1974 Kay. 1981 Gravlin L6 P203-204, find 1/2" iron, N50E 34.50' 24" maple, N1W 45.45' 10" maple, N45W 32.68' 10" maple. 1993 Field L5 P66 Act 74, 1/2" rod w/standard brass cap, N02E 45.40' set nail w/remon tag above find nail w/flag W face 10" maple, N58E 34.49' set nail w/remon tag above find nail above find PK nail w/flag S face 30" maple, N35W 28.30' set nail w/remon tag above find PK nail w/disc in SW face 8" elm, S43E 31.75' find PK nail w/disc in NE corn of 6x8 wood fnc cor post fnc S-E-W, N72W 72.42' set nail w/remon tag S face 10" maple, North 33.00' find 1/2" rod w/cap #18986, West 50+/- centerline of creek.

B. Description of corner evidence found and/or method applied in restoring or reestablishing corner:
Found standard brass cap on 1/2" iron on centerline of road.
Witnesses match M-13 T9N-R10E.
A-13 T9N-R11E, M-13 T9N-R10E, M-1 T8N-R10E common to A-1
A-1 to A-2 2924.01' 2924.07'
A-1 to M-2 T8N-R10E 3033.67'



C. Description of monument for corner and accessories established to perpetuate locating the position of the corner:
A-1 section corner section 6
Found standard brass cap on 1/2" rod
N02E 45.40' found nail w/remon tag above find nail w/flag W face 10" maple
N58E 34.49' found nail w/remon tag above find nail above find PK nail w/flag S face 30" maple
N35W 28.30' found nail w/remon tag above find PK nail w/disc in SW face 8" elm
S43E 31.75' found PK nail w/disc in NE corn of 6x8 wood fnc cor post fnc S-E-W
N72W 72.42' found nail w/remon tag S face 10" maple
North 33.00' found 1/2" rod w/cap #18986
West 50+/- centerline of creek

PEER GROUP
APPROVED LAND CORNER
PA 845 OF 1980
LAPEER COUNTY

RAY DAVIS P.S. CO. SURVEYOR
DATE 10-21-99

Signed by [Signature] Date DEC 2 1999
Surveyor's Michigan License No. 23510