

SURVEY & REMONUMENTATION

MAR 23 2000

REMONUMENTATION

RECEIVED FOR RECORD

LAND CORNER RECORDATION CERTIFICATE

00 FEB 10 PM 2:18

SECTION

Filing Requirement of Act 74, Mich. P.A. 1970

For corners in

Melissa DeVaugh
REGISTER OF DEEDS
LAPEER COUNTY, MICHIGAN

LAPEER Located In: ARCADIA TWP. Corner Code # A-10
(County)


1. Public Land Survey T 8 R 11
T _____ R _____
T _____ R _____
T _____ R _____

2. Property Controlling S _____ T _____ R _____
in Section S _____ T _____ R _____

3. Miscellaneous S _____ T _____ R _____
Property in Sec. S _____ T _____ R _____

4. Lot No. _____, Recorded Plat _____

5. Private Claims _____

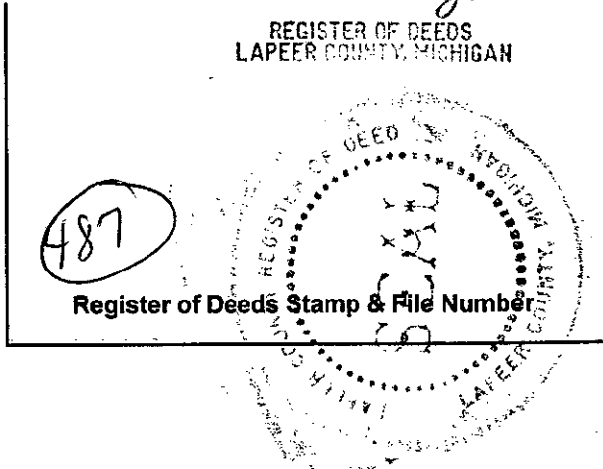

	A	B	C	D	E	F	G	H	I	J	K	L	M
1													
2	6	5	4	3	2	1							
3													
4	7	8	9	10	11	12							
5													
6	18	17	16	15	14	13							
7													
8	19	20	21	22	23	24							
9													
10	30	29	28	27	26	25							
11													
12	31	32	33	34	35	36							
13													

I, MICHAEL G. HAY, in a field survey on AUGUST 22, 1999, do hereby certify that under requirements of P.A. 74, Michigan P.A. of 1970, the corner points mentioned in lines 1 and 2 above were in conformance with regulations and rules therefore as required in the current manual of survey instructions of the United States Department of the Interior, Bureau of Land Management or by a decree of a Court of Law and/or that the corner points mentioned in lines 3, 4 and 5 above were in conformance with the rules of the Michigan Board of Land Surveyors or by a Decree of a Court of Law; established, re-established, monumented, re-monumented, recovered, found as expressed below:

NOTE: Not more than 4 corners, all in the same town and range, may be recorded on this certificate.

- A. Description of original monument and accessories and/or subsequent restoration:
GLO- NO NOTES
1872- GILBERT BATES C.S. STONE 24-15-06 SMALL STONES
1969- HENDERSON AND BATES P.S. 16043 (NOT RECORDED) SET 1/2" IRON
1976- BERNARD HENDERSON P.S. 16043 (SURVEY) LIBER 3 PAGE 793 FOUND IRON
1976- PAUL E. PANGUS P.S. 21578 (NOT RECORDED) FOUND 1/2" RE-ROD
1979- CHARLES S. GETZ P.S. 25843 (SURVEY) LIBER 5 PAGES 209-210 FOUND 1/2" IRON


PEER GROUP
APPROVED LAND CORNER
PA 345 OF 1990
LAPEER COUNTY

Ray Davis
RAY DAVIS P.S. CO. SURVEYOR
DATE 11-10-1999

- B. Description of corner evidence found and/or method applied in restoring or reestablishing corner:
1999- MICHAEL G. HAY P.S. 41101 FOUND NO CORNER. SET 1/2" IRON WITH REMONUMENTATION CAP ON LINE BETWEEN M-10 AND M-9 AND HALF THE DISTANCE BETWEEN A-9 AND A-11. NO OCCUPATION EAST OR WEST.

A-10 TO A-11 2651.28'
A-10 TO A-9 2651.28'

- C. Description of monument for corner and accessories established to perpetuate locating the position of the corner:
SET STANDARD REMONUMENTATION ON 1/2" IRON
N08E 233.15' SET PK NAIL IN W. FACE POWER POLE
S35E 54.00' SET PK NAIL IN E. FACE POWER POLE
S05E 316.72' SET PK NAIL IN W. FACE POWER POLE
S20W 134.03' SPIKE E. FACE 5" ELM
SOUTH 42.06' FND REMONUMENTATION CAP. # 18986

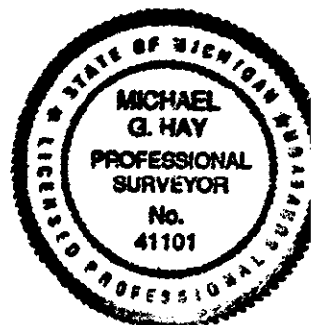

Signed by Michael G. Hay Date 1-11-2000
Surveyor's Michigan License No. 41101

FORM APPROVED BY MICHIGAN STATE BOARD OF LAND SURVEYORS, JAN. 28, 1971