

SURVEY & REMONUMENTATION

MAR 23 2000

REMONUMENTATION

RECEIVED FOR RECORD

SECTION

LAND CORNER RECORDATION CERTIFICATE

00 FEB 10 PM 2:19

Filing Requirement of Act 74, Mich. P.A. 1970

For corners in


LAPEER

(County)

Located In:
ARCADIA TWP.

Corner Code #

- | | | | |
|------------------------------------|--------------|---------------|-------------|
| 1. Public Land Survey | T <u>8</u> N | R <u>11</u> E | <u>A-11</u> |
| | T _____ | R _____ | _____ |
| | T _____ | R _____ | _____ |
| | T _____ | R _____ | _____ |
| 2. Property Controlling in Section | S _____ | T _____ | R _____ |
| | S _____ | T _____ | R _____ |
| 3. Miscellaneous Property in Sec. | S _____ | T _____ | R _____ |
| | S _____ | T _____ | R _____ |
4. Lot No. _____, Recorded Plat _____
5. Private Claims _____

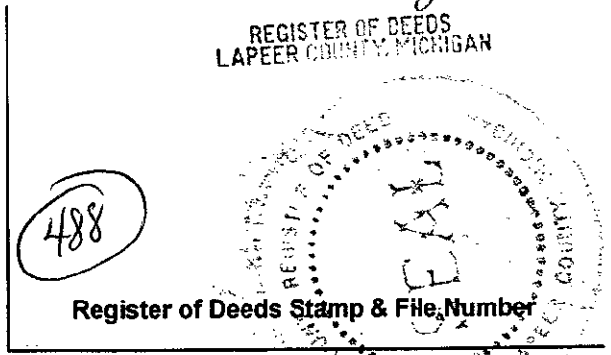

	A	B	C	D	E	F	G	H	I	J	K	L	M
1													
2	6	5	4	3	2	1							
3													
4	7	8	9	10	11	12							
5													
6	18	17	16	15	14	13							
7													
8	19	20	21	22	23	24							
9													
10	30	29	28	27	26	25							
11													
12	31	32	33	34	35	36							
13													

I, MICHAEL G. HAY, in a field survey on AUGUST 22, 1999, do hereby certify that under requirements of P.A. 74, Michigan P.A. of 1970, the corner points mentioned in lines 1 and 2 above were in conformance with regulations and rules therefore as required in the current manual of survey instructions of the United States Department of the Interior, Bureau of Land Management or by a decree of a Court of Law and/or that the corner points mentioned in lines 3, 4 and 5 above were in conformance with the rules of the Michigan Board of Land Surveyors or by a Decree of a Court of Law; established, re-established, monumented, re-monumented, recovered, found as expressed below:

NOTE: Not more than 4 corners, all in the same town and range, may be recorded on this certificate.


- A. Description of original monument and accessories and/or subsequent restoration:
 1822- JOSEPH WAMPLER D.S. SET POST AT INTERSECTION OF CORNERS TO SECTIONS 30 & 31
 1872- GILBERT BATES C.S. STAKE
 1969- HENDERSON AND BATES P.S. 16043 (NOT RECORDED) FOUND 1/2" IRON
 1976- BERNARD HENDERSON P.S. 16043 (SURVEY) LIBER 3 PAGE 793 FOUND IRON
 1979- CHARLES GETZ P.S. 25843 (SURVEY) LIBER 5 PAGE 209 FOUND 1/2" IRON
 1992- RUSSELL L. BROWN R.L.S.24588 LIBER 10 PAGES 453-455

PEER GROUP
 APPROVED LAND CORNER
 PA 345 OF 1990
 LAPEER COUNTY

Michael G. Hay
 RAY DAVIS P.S. CO. SURVEYOR
 DATE 11-10-1999

- B. Description of corner evidence found and/or method applied in restoring or reestablishing corner:
 1999- MICHAEL G. HAY P.S. 41101 FOUND 1/2" IRON ONE FOOT EAST OF CENTERLINE OF FIVE LAKES ROAD (GRAVEL) AND TWO FEET SOUTH OF THE CENTERLINE OF HAINES ROAD (GRAVEL) TO THE EAST.
- A-11 TO B-11 2415.92' (36.62 GLO) 2424.18'(36.73 COUNTY) 2427.41' (HBE)
 A-11 TO A-12 2668.16' (M)
 A-11 TO A-10 2651.28 (M)
 A-11 TO M-11 25.01' (M) 36.30' (55 GLO) 24.90' (REMON L.C.R.C. (HBE))

- C. Description of monument for corner and accessories established to perpetuate locating the position of the corner:
 SET STANDARD REMONUMENTATION CAP ON 1/2" IRON
 S45E 62.82' NAIL AND TAG LAPEER WITNESS NE FACE POWER POLE
 S40W 85.16' NAIL AND TAG LAPEER WITNESS N FACE GUY POLE
 N40E 40.23' NAIL AND TAG LAPEER WITNESS NW FACE POWER POLE
 SOUTH 25.01' LAPEER COUNTY REMONUMENTATION CAP

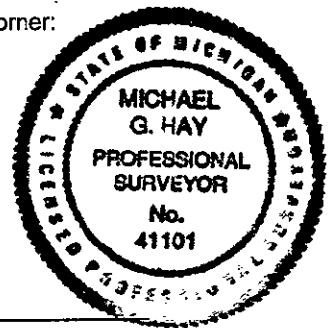

Signed by Michael G. Hay Date 1-11-2000
 Surveyor's Michigan License No. 41101