

SURVEY &  
REMONUMENTATION

MAR 23 2000

REMONUMENTATION

RECEIVED FOR RECORD

SECTION

LAND CORNER RECORDATION CERTIFICATE

00 FEB 10 PM 2:19

Filing Requirement of Act 74, Mich. P.A. 1970

For corners in

LAPEER

(County)

Located in:  
ARCADIA TWP.

Corner Code #

- |                                       |            |             |             |
|---------------------------------------|------------|-------------|-------------|
| 1. Public Land Survey                 | T <u>8</u> | R <u>11</u> | <u>A-12</u> |
|                                       | T _____    | R _____     | _____       |
|                                       | T _____    | R _____     | _____       |
|                                       | T _____    | R _____     | _____       |
| 2. Property Controlling<br>in Section | S _____    | T _____     | R _____     |
|                                       | S _____    | T _____     | R _____     |
| 3. Miscellaneous<br>Property in Sec.  | S _____    | T _____     | R _____     |
|                                       | S _____    | T _____     | R _____     |

4. Lot No. \_\_\_\_\_, Recorded Plat \_\_\_\_\_  
5. Private Claims \_\_\_\_\_

I, MICHAEL G. HAY, in a field survey on AUGUST 22, 1999, do hereby certify that under requirements of P.A. 74, Michigan P.A. of 1970, the corner points mentioned in lines 1 and 2 above were in conformance with regulations and rules therefore as required in the current manual of survey instructions of the United States Department of the Interior, Bureau of Land Management or by a decree of a Court of Law and/or that the corner points mentioned in lines 3, 4 and 5 above were in conformance with the rules of the Michigan Board of Land Surveyors or by a Decree of a Court of Law; established, re-established, monumented, re-monumented, recovered, found as expressed below:

NOTE: Not more than 4 corners, all in the same town and range, may be recorded on this certificate.

A. Description of original monument and accessories and/or subsequent restoration:  
GLO- NO NOTES  
1980- PAUL E. PANGUS P.S. 21578 (SURVEY) LIBER 6 PAGES 72-75  
1992- RUSSELL L. BROWN P.S. 24588 LIBER 10 PAGES 453-455 FOUND 1/2" RE-ROD

B. Description of corner evidence found and/or method applied in restoring or reestablishing corner:  
1999- MICHAEL G. HAY P.S. 41101 FOUND 1/2" IRON IN THE CENTERLINE OF FIVE LAKE ROAD (GRAVEL).  
NO OCCUPATION EAST. TREE LINE RUNNING WEST.  
A-12 TO A-13 2638.10' (M) 2638.29' (PANGUS)  
A-12 TO A-11 2668.16 (M)  
A-12 TO M-12 3.53' (M) SOUTH

C. Description of monument for corner and accessories established to perpetuate locating the position of the corner:  
SET STANDARD REMONUMENTATION CAP ON 1/2" IRON  
S25E 89.12' NAIL AND TAG LAPEER WITNESS W FACE POWER POLE  
S25W 84.83' NAIL AND TAG LAPEER WITNESS E FACE POWER POLE  
S80W 50.62' NE CORNER CHURCH  
S85W 33.77' FIC 23510  
SOUTH 3.53' LAPEER COUNTY REMONUMENTATION CAP

Melissa De Vaughn  
REGISTER OF DEEDS  
LAPEER COUNTY, MICHIGAN


489

Register of Deeds Stamp & File Number

	A	B	C	D	E	F	G	H	I	J	K	L	M
1													
2	6	5	4	3	2	1							
3													
4	7	8	9	10	11	12							
5													
6	18	17	16	15	14	13							
7													
8	19	20	21	22	23	24							
9													
10	30	29	28	27	26	25							
11													
12	31	32	33	34	35	36							
13													

PEER GROUP  
APPROVED LAND CORNER  
PA 345 OF 1990  
LAPEER COUNTY

RAY DAVIS P.S. CO. SURVEYOR  
DATE 11-10-1999

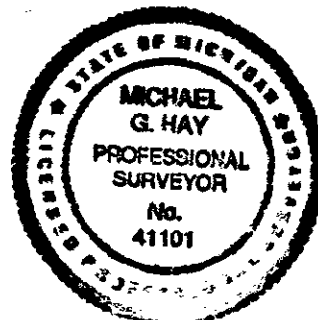

Signed by Michael G. Hay Date 1-11-2000

Surveyor's Michigan License No. 41101

FORM APPROVED BY MICHIGAN STATE BOARD OF LAND SURVEYORS, JAN. 23, 1971