

SURVEY & REMONUMENTATION

MAR 23 2000

SECTION

**REMONUMENTATION
LAND CORNER RECORDATION CERTIFICATE
Filing Requirement of Act 74, Mich. P.A. 1970**

RECEIVED FOR RECORD

00 FEB 10 PM 2:19

Melissa DeVaugh
REGISTER OF DEEDS
LAPEER COUNTY, MICHIGAN

For corners in

LAPEER Located In: ARACADIA TWP. Corner Code # _____
(County)


1. Public Land Survey T 8 N R 11 E M-1
T _____ R _____
T _____ R _____
T _____ R _____

2. Property Controlling S _____ T _____ R _____
in Section S _____ T _____ R _____

3. Miscellaneous S _____ T _____ R _____
Property in Sec. S _____ T _____ R _____

4. Lot No. _____ Recorded Plat _____

5. Private Claims _____

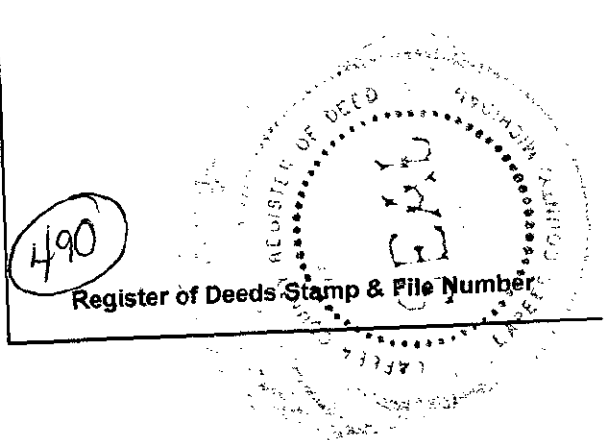

	A	B	C	D	E	F	G	H	I	J	K	L	M
1													
2	6	5	4	3	2	1							
3													
4	7	8	9	10	11	12							
5													
6	18	17	16	15	14	13							
7													
8	19	20	21	22	23	24							
9													
10	30	29	28	27	26	25							
11													
12	31	32	33	34	35	36							
13													

I, MICHAEL G. HAY, in a field survey on AUGUST 22 19 99, do hereby certify that under requirements of P.A. 74, Michigan P.A. of 1970, the corner points mentioned in lines 1 and 2 above were in conformance with regulations and rules therefore as required in the current manual of survey instructions of the United States Department of the Interior, Bureau of Land Management or by a decree of a Court of Law and/or that the corner points mentioned in lines 3, 4 and 5 above were in conformance with the rules of the Michigan Board of Land Surveyors or by a Decree of a Court of Law; established, re-established, monumented, re-monumented, recovered, found as expressed below:

NOTE: Not more than 4 corners, all in the same town and range, may be recorded on this certificate.

A. Description of original monument and accessories and/or subsequent restoration:
1822- JOSEPH WAMPLER SET POST
1974- HERBERT J. KOBS P.S. 14097 (SURVEY) LIBER 3 PAGES 39-42

PEER GROUP
APPROVED LAND CORNER
PA 345 OF 1990
LAPEER COUNTY
RAY DAVIS P.S. CO. SURVEYOR
DATE 11-10-1999

B. Description of corner evidence found and/or method applied in restoring or reestablishing corner:
1999-MICHAEL G. HAY FOUND REMONUMENTATION CAP IN MON BOX 2 FEET NORTH OF CENTERLINE OF CLEAR LAKE ROAD (PAVED) AND ON CENTERLINE OF SUMMERS ROAD (GRAVEL)
M-1 TO L-1 2603.24' (M) 2603.31' (KOBS)
M-1 TO B-1 2492.13' (M)
M-1 TO M-12 2628.88' (M) 2628.98' REMON LCRC (L6 P91) REMON LCRC (L5 P44) 2640.00' (40 GLO)
M-1 TO M-2 2793.57' (M) 2793.34' (KOBS) 2640.00' (40 GLO) 2793.78' 2793.78' (42.33' COUNTY)

C. Description of monument for corner and accessories established to perpetuate locating the position of the corner:
FOUND REMONUMENTATION CAP ON 1/2" IRON
S 15 W 99.27' NAIL AND TAG W FACE 20" MAPLE
S 10 E 98.72' NAIL AND TAG E FACE 18" ELM
N 20 E 106.39' NAIL AND TAG E FACE GTE POLE
N 20 W 125.81' NAIL AND TAG E FACE 24" MAPLE



Signed by Michael G. Hay Date 1-11-2000
Surveyor's Michigan License No. 41101

FORM APPROVED BY MICHIGAN STATE BOARD OF LAND SURVEYORS, JAN. 28, 1971

REVISED MAY 14, 1975
REVISED JAN., 1983
ADAPTED FOR WORD PROCESSING MARCH, 1993