

**SURVEY &
REMONUMENTATION**

MAR 23 2000

SECTION

REMONUMENTATION

LAND CORNER RECORDATION CERTIFICATE

Filing Requirement of Act 74, Mich. P.A. 1970


RECEIVED FOR RECORD

00 FEB 10 PM 2: 19

Melissa DeVaugh
REGISTER OF DEEDS
LAPEER COUNTY, MICHIGAN

For corners in

<u>LAPEER</u>	Located In:	Corner Code #
(County)	ARCADIA TWP.	
1. Public Land Survey	T <u>8</u> N R <u>11</u> E	<u>M-2</u>
	T _____ R _____	_____
	T _____ R _____	_____
	T _____ R _____	_____
2. Property Controlling in Section	S _____ T _____ R _____	_____
	S _____ T _____ R _____	_____
3. Miscellaneous Property in Sec.	S _____ T _____ R _____	_____
	S _____ T _____ R _____	_____

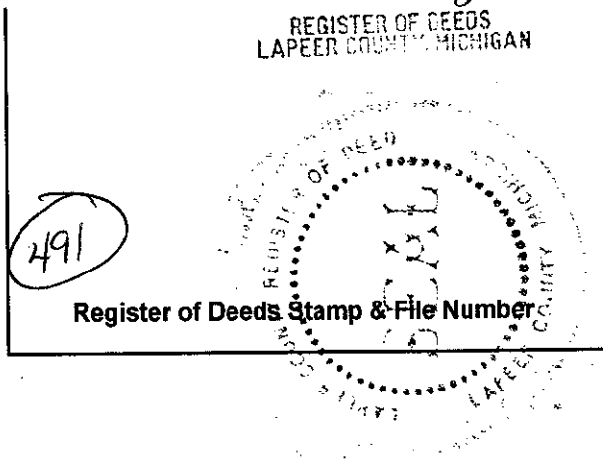

4. Lot No. _____, Recorded Plat _____
5. Private Claims _____

I, MICHAEL G. HAY, in a field survey on AUGUST 22, 1999, do hereby certify that under requirements of P.A. 74, Michigan P.A. of 1970, the corner points mentioned in lines 1 and 2 above were in conformance with regulations and rules therefore as required in the current manual of survey instructions of the United States Department of the Interior, Bureau of Land Management or by a decree of a Court of Law and/or that the corner points mentioned in lines 3, 4 and 5 above were in conformance with the rules of the Michigan Board of Land Surveyors or by a Decree of a Court of Law; established, re-established, monumented, re-monumented, recovered, found as expressed below:

1	A	B	C	D	E	F	G	H	I	J	K	L	M
2	6	5	4	3	2	1							
3													
4	7	8	9	10	11	12							
5													
6	18	17	16	15	14	13							
7													
8	19	20	21	22	23	24							
9													
10	30	29	28	27	26	25							
11													
12	31	32	33	34	35	36							
13													


NOTE: Not more than 4 corners, all in the same town and range, may be recorded on this certificate.

A. Description of original monument and accessories and/or subsequent restoration:
1822- JOSEPH WAMPLER D.S. SET POST
1878- GILBERT BATES C.S. SET STAKE
1974- HERBERT J. KOBS R.L.S. 14097 (SURVEY) LIBER 3 PAGES 39-42 FOUND 1/2" IRON BAR PEER GROUP

APPROVED LAND CORNER
PA 545 OF 1990
LAPEER COUNTY
Ray Davis
RAY DAVIS P.S. CO. SURVEYOR
DATE 11-10-1999

B. Description of corner evidence found and/or method applied in restoring or reestablishing corner:
1999-MICHAEL G. HAY P.S. 41101 FOUND 1/2" IRON TWO FEET WEST OF CENTERLINE OF SUTTON ROAD (GRAVEL). TREE LINE STARTS 660' PLUS OR MINUS TO THE WEST.
M-2 TO M-1 2793.57' (M) 2793.34' (KOBS)
M-2 TO M-3 2759.98 (M) 2760.00' (KOBS)
M-2 TO A-2 54.02 NORTH (M)

C. Description of monument for corner and accessories established to perpetuate locating the position of the corner:
SET STANDARD REMONUMENTATION CAP ON 1/2" IRON
S85E 34.50' NAIL AND ROWE TAG N FACE 8" POPLAR
N50W 83.66' NAIL AND ROWE TAG NE FACE POWER POLE
N35W 81.69' NAIL AND ROWE TAG E FACE GUY POLE
N80W 24.27' NOTCH S. END CMP S. SIDE SKY VIEW DRIVE

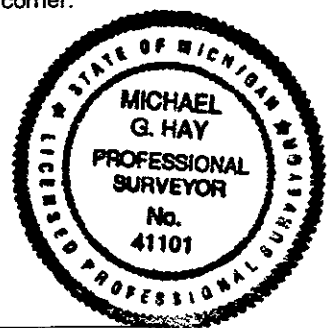

Signed by Michael G. Hay Date 1-11-2000
Surveyor's Michigan License No. 41101

FORM APPROVED BY MICHIGAN STATE BOARD OF LAND SURVEYORS, JAN. 28, 1971