

SURVEY & REMONUMENTATION

MAR 23 2000

SECTION

REMONUMENTATION

LAND CORNER RECORDATION CERTIFICATE

Filing Requirement of Act 74, Mich. P.A. 1970

RECEIVED FOR RECORD

00 FEB 10 PM 2:19

For corners in

LAPEER Located In: ARCADIA TWP. Corner Code # _____
 (County)


1. Public Land Survey T 8 N R 11 E M-3
 T _____ R _____
 T _____ R _____
 T _____ R _____

2. Property Controlling S _____ T _____ R _____
 in Section S _____ T _____ R _____

3. Miscellaneous S _____ T _____ R _____
 Property in Sec. S _____ T _____ R _____

4. Lot No. _____, Recorded Plat _____

5. Private Claims _____

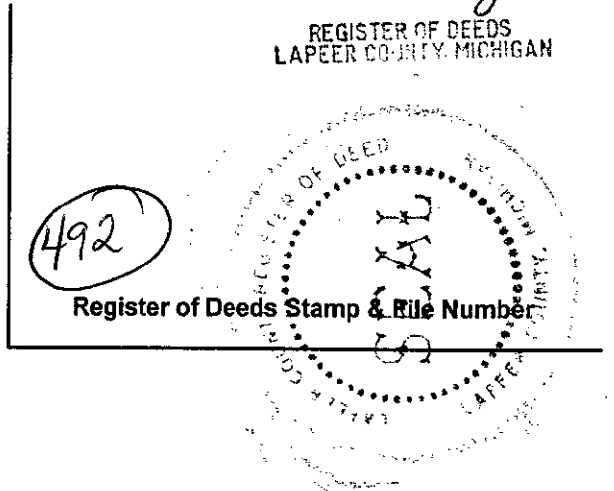

	A	B	C	D	E	F	G	H	I	J	K	L	M
1													
2	6	5	4	3	2	1							
3													
4	7	8	9	10	11	12							
5													
6	18	17	16	15	14	13							
7													
8	19	20	21	22	23	24							
9													
10	30	29	28	27	26	25							
11													
12	31	32	33	34	35	36							
13													

I, MICHAEL G. HAY, in a field survey on AUGUST 22, 1999, do hereby certify that under requirements of P.A. 74, Michigan P.A. of 1970, the corner points mentioned in lines 1 and 2 above were in conformance with regulations and rules therefore as required in the current manual of survey instructions of the United States Department of the Interior, Bureau of Land Management or by a decree of a Court of Law and/or that the corner points mentioned in lines 3, 4 and 5 above were in conformance with the rules of the Michigan Board of Land Surveyors or by a Decree of a Court of Law; established, re-established, monumented, re-monumented, recovered, found as expressed below:

NOTE: Not more than 4 corners, all in the same town and range, may be recorded on this certificate.

- A. Description of original monument and accessories and/or subsequent restoration:
 1822- JOSEPH WAMPLER D.S SET POST
 1973- HERBERT J. KOBS L.S. 14097 (SURVEY) LIBER 2 PAGES 12-13 FOUND 1/2" IRON BAR
 1974- HERBERT J. KOBS L.S. 14097 (SURVEY) LIBER 3 PAGES 39-42 FOUND 1/2" IRON BAR
 1984- HERBERT J. KOBS L.S. 14097 (SURVEY) LIBER 006 PAGE 644 FOUND 1/2" IRON BAR
 1984- WILLIAM G. CARLSON L.S. 14759 (SURVEY) LIBER 006 PAGES 736-737 SET 1/2" STEEL ROD
 1984- WILLIAM G. CARLSON L.S. 14759 (LCRC) LIBER 004 PAGE 73 SET 1/2" STEEL ROD
 1991- EARL E. GRAVLIN L.S. 23510 (SURVEY) LIBER 10 PAGE 119

PEER GROUP
 APPROVED LAND CORNER
 PA 345 OF 1990
 LAPEER COUNTY

Ray Davis
 RAY DAVIS P.S. CO. SURVEYOR
 DATE 11-10-1999

- B. Description of corner evidence found and/or method applied in restoring or reestablishing corner:
 1999-MICHAEL G. HAY P.S. 41101 FOUND 1/2" IRON ON THE EAST EDGE OF SUMMERS ROAD (GRAVEL)
 NO OCCUPATION EAST OR WEST.
 M-3 TO M-2 2759.98'(M) 2760.00'(KOB) 2640.00'(40 GLO) 2760.00'(CARLSON)
 M-3 TO M-4 2598.59'(M) 2640.00'(GLO)
 M-3 TO A-3 144.66'(M) 196.00'(297 GLO)

- C. Description of monument for corner and accessories established to perpetuate locating the position of the corner:
 SET STANDARD REMONUMENTATION CAP ON 1/2" IRON
 N45W 48.43' NAIL AND TAG NE FACE 30" POPLAR
 S80E 29.42' NAIL AND ROWE TAG N. FACE 6" BIRCH
 S40W 45.37' NAIL AND ROWE TAG SE FACE 10' WHITE PINE
 N10E 59.25' NAIL AND ROWE TAG W FACE 10" ELM



Signed by Michael G. Hay Date 1-11-2000
 Surveyor's Michigan License No. 41101

FORM APPROVED BY MICHIGAN STATE BOARD OF LAND SURVEYORS, JAN. 28, 1971

LIBER 0006 PAGE 0288

REVISED MAY 14, 1975
 REVISED JAN., 1983
 ADAPTED FOR WORD PROCESSING MARCH, 1993