

**SURVEY &
REMONUMENTATION**

APR 29 1996

COMMISSION

LAND CORNER RECORDATION CERTIFICATE

Filing Requirement of Act 74, Mich. P.A. 1970

RECEIVED FOR RECORD

For corners in
LAPEER
County

Located In:
ARCADIA TOWNSHIP

Corner Code #

- | | | | | | |
|--------------------------------------|---|-----------|---|------------|------------|
| 1. Public Land Survey | T | <u>8N</u> | R | <u>11E</u> | <u>M-5</u> |
| | T | | R | | |
| | T | | R | | |
| | T | | R | | |
| 2. Property Controlling in Section | S | | T | | |
| | S | | T | | |
| 3. Miscellaneous Property in Section | S | | T | | |
| | S | | T | | |

95 DEC 28 PM 2:43
LIBER NO. 005 PAGE NO. 330
Patricia DeLong
REGISTER OF DEEDS
LAPEER COUNTY MICHIGAN

Register of Deeds Stamp & File Number

4. Lot No. _____, Recorded Plat _____
5. Private Claims _____

A	B	C	D	E	F	G	H	I	J	K	L	M
2	6	5	4	3	2	1						
3												
4	7	6	9	10	11	12						
5												
6	18	17	16	15	14	13						
7												
8	19	20	21	22	23	24						
9												
10	30	29	28	27	26	25						
11												
12	31	32	33	34	35	36						
13												

I, James T. Bailey, in a field survey on December 6, 19 95, do hereby certify that under requirements of P.A. 74, Michigan P.A. of 1970, the corner points mentioned in lines 1 and 2 above were in conformance with regulations and rules therefore as required in the current manual of survey instructions of the United States Department of the Interior, Bureau of Land Management or by a decree of a Court of Law and/or that the corner points mentioned in lines 3, 4 and 5 above were in conformance with the rules of the Michigan Board of Professional Surveyors or by a Decree of a Court of Law; established, re-established, monumented, re-monumented, recovered, found as expressed below:

NOTE: Not more than 4 corners, all in the same town and range, may be recorded on this certificate.

A. Description of original monument and accessories and/or subsequent restoration:

- G.L.O. (1822) JOSEPH WAMPLER D.S. SET POST NO WITNESSES FOUND
- SURVEY (9/3/86) KAY P.S. UNRECORDED FOUND 1/2" IRON

B. Description of corner evidence found and/or method applied in restoring or reestablishing corner:

1995 JAMES T. BAILEY P.S. FOUND 1/2" ROD 4" BELOW GRADE AT THE CENTERLINE OF SUMMERS ROAD (GRAVEL) AND THE EXTENTION OF A TREE AND ROCK ROW TO THE WEST. REMAINING WITNESSES FROM ITEM #2 ABOVE MATCH.


DISTANCE TO M-4 2666.33

PEEP GROUP
APPROVED LAND CORNER
PALENT OF
LAPEER COUNTY
Ray David
RAY DAVID S. COO SURVEYOR
DATE 7-13-95

C. Description of monument for corner and accessories established to perpetuate locating the position of the corner:

M-5 SET STANDARD LAPEER COUNTY REMONUMENTAION CAP ON FOUND 1/2" ROD.

- N.60°E. 84.10 SET PK NAIL W/ REMON TAG IN 18" ELM
- S.40°W. 56.59 SET PK NAIL W/ REMON TAG IN POWER POLE
- S.85°W. 37.08 SET PK NAIL W/ REMON TAG IN 8" OAK
- N.45°W. 34.99 SET PK NAIL W/ REMON TAG IN TRI 8" OAK

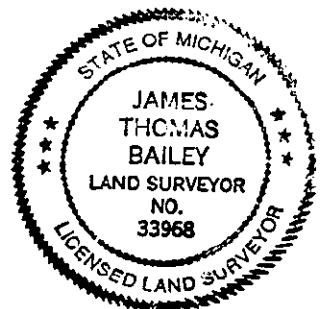

Signed by *JT Bailey*
Surveyor's Michigan License No. 33968

Date DECEMBER 19, 1995