

**SURVEY &  
REMONUMENTATION**

**MAR 28 2000**

**REMONUMENTATION**

**LAND CORNER RECORDATION CERTIFICATE  
Filing Requirement of Act 74, Mich. P.A. 1970  
GOODLAND TOWNSHIP**

**SECTION**

For corners in

RECEIVED FOR RECORD

00 JAN 19 AM 8:48

*William DeVaugh*  
REGISTER OF DEEDS  
LAPEER COUNTY MICHIGAN

Register of Deeds Stamp & File Number

462

LAPEER Located In: \_\_\_\_\_ Corner Code # \_\_\_\_\_  
(County)

1. Public Land Survey T 8 N R 12 E A-1  
T \_\_\_\_\_ R \_\_\_\_\_  
T \_\_\_\_\_ R \_\_\_\_\_  
T \_\_\_\_\_ R \_\_\_\_\_

2. Property Controlling in Section S \_\_\_\_\_ T \_\_\_\_\_ R \_\_\_\_\_  
S \_\_\_\_\_ T \_\_\_\_\_ R \_\_\_\_\_

3. Miscellaneous Property in Sec. S \_\_\_\_\_ T \_\_\_\_\_ R \_\_\_\_\_  
S \_\_\_\_\_ T \_\_\_\_\_ R \_\_\_\_\_

4. Lot No. \_\_\_\_\_, Recorded Plat \_\_\_\_\_  
5. Private Claims \_\_\_\_\_

I, SHELBY W. MONEY, in a field survey on September 25, 19 99 do hereby certify that under requirements of P.A. 74, Michigan P.A. of 1970, the corner points mentioned in lines 1 and 2 above were in conformance with regulations and rules therefore as required in the current manual of survey instructions of the United States Department of the Interior, Bureau of Land Management or by a decree of a Court of Law and /or that the corner points mentioned in lines 3, 4 and 5 above were in conformance with the rules of the Michigan Board of Land Surveyors or by a Decree of a Court of Law; established, re-established, monumented, re-monumented, recovered, found as expressed below:

**NOTE: Not more than 4 corners, all in the same town and range, may be recorded on this certificate.**

A. Description of original monument and accessories and/or subsequent restoration:

- GLO 1816 Joseph Wampler Set post No witnesses remain
- L3, Pg 39, August 1974 survey by Kobs Land Surveying, Found "T" bar. M-1, T8N, R11E
  - L2, Pg 697, November 1974 LCRC by Herbert Kobs, Found "T" iron. M-1, T8N, R11E
  - L4, Pg 452, February 1978 survey by Henderson Bates, Found "T" iron. A-1, T8N, R12E
  - L5, Pg 888, September 1980 survey by Henderson Bates, Found "T" iron. M-1, T8N, R11E
  - L6, Pg 644 August 1983 survey by Kobs Land Surveying, Found "T" bar. M-1, T8N, R11E
  - L6, Pg 862 August 1984 survey by survey by Henderson Bates. A-1, T8N, R12E
  - L5, Pg 44 November 1993 LCRC by Earl Gravlin, Found 1/2" rod in Mon.Box. M-13, T9N, R11E
  - L6, Pg 91 November 1997 LCRC by Earl Gravlin, Found iron with Remon Cap. In Mon Box. A-13, T9N, R12E

B. Description of corner evidence found and/or method applied in restoring or reestablishing corner:

Found a standard Lapeer County Remon cap in monument box in asphalt road. The corner is in the centerline of Summers Road (asphalt) North and South and Clear Lake Road (asphalt) East and West. The following witnesses from the recorded documents were used to locate the corner:

The found corner is Common with M-13 North Branch T.9N.,R11E., A-13 Burnside T.9N.,R12E and M-1 Arcadia T.8N.,R11E


Witness found: From items 7 and 8,  
S 15°W 100.02' Fnd nail with Lapeer remon in West face of 23" Maple.  
N 20° W 126.05' Found nail with Lapeer remon. witness tag in East face of 24" Maple.

C. Description of monument for corner and accessories established to perpetuate locating the position of the corner:

A-1 Found iron with Remon Cap in Mon. Box. is the best location for this corner as accepted by the Professional Surveyors in this area.

- AZ 20° 106.48' Found nail with Lapeer County remon. witness tag in East face Michigan Bell Telephone pole.
- AZ 165° 98.81' Set mag nail with Lapeer remon. tag in West face of triple 12" Elm.
- AZ 205° 99.78' Set mag nail in West face of 23" Maple.
- AZ 350° 125.90' Found nail with Lapeer remon. witness tag in East face of 24" Maple.
- A-1 TO A-2 2739.45'

Signed by *Shelby W. Money*  
Surveyor's Michigan License No. 30092

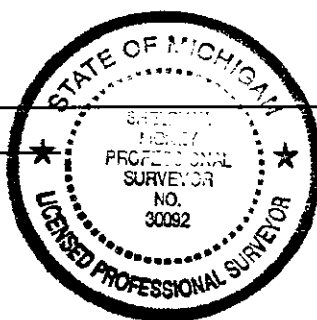

Date 12/29, 1999