

**SURVEY &
REMONUMENTATION**

MAR 28 2000

SECTION

REMONUMENTATION

**LAND CORNER RECORDATION CERTIFICATE
Filing Requirement of Act 74, Mich. P.A. 1970
GOODLAND TOWNSHIP**

RECEIVED FOR RECORD

00 JAN 19 AM 8:49

Melvin D. Vaughn
REGISTER OF DEEDS
LAPEER COUNTY, MICHIGAN

For corners in

<u>LAPEER</u>	Located In:	Corner Code #
(County)		
1. Public Land Survey	T <u>8</u> N R <u>12</u> E	<u>A-6</u>
	T _____ R _____	_____
	T _____ R _____	_____
	T _____ R _____	_____
2. Property Controlling in Section	S _____ T _____ R _____	_____
	S _____ T _____ R _____	_____
3. Miscellaneous Property in Sec.	S _____ T _____ R _____	_____
	S _____ T _____ R _____	_____

467

Register of Deeds Stamp & File Number

4. Lot No. _____, Recorded Plat _____
5. Private Claims _____

	A	B	C	D	E	F	G	H	I	J	K	L	M	
1														
2	6			5			4			3			2	1
3														
4	7			8			9			10			11	12
5														
6	18			17			16			15			14	13
7														
8	19			20			21			22			23	24
9														
10	30			29			28			27			26	25
11														
12	31			32			33			34			35	36
13														

I, SHELBY W. MONEY, in a field survey on September 24, 19 99 do hereby certify that under requirements of P.A. 74, Michigan P.A. of 1970, the corner points mentioned in lines 1 and 2 above were in conformance with regulations and rules therefore as required in the current manual of survey instructions of the United States Department of the Interior, Bureau of Land Management or by a decree of a Court of Law and /or that the corner points mentioned in lines 3, 4 and 5 above were in conformance with the rules of the Michigan Board of Land Surveyors or by a Decree of a Court of Law; established, re-established, monumented, re-monumented, recovered, found as expressed below:

NOTE: Not more than 4 corners, all in the same town and range, may be recorded on this certificate.

A. Description of original monument and accessories and/or subsequent restoration:

- GLO Not set by the GLO
- L3, Pg 99, June 1975 LCRC by Bernard Henderson, Found 1/2" iron rod. A-6, T8N, R12E
 - L3, Pg 392, June 1975 survey by Bernard Henderson, Found 1/2" iron rod. A-5, T8N, R12E
 - L3, Pg 444, September 1975 survey by Bernard Henderson, Found 1/2" iron rod. A-5, T8N, R12E
 - L6, Pg 1000, May 1985 survey by Earl Gravlin, Found 1/2" iron rod. A-5, T8N, R12E

B. Description of corner evidence found and/or method applied in restoring or reestablishing corner:

Found a 1/2" rerod in Summers Road (gravel) road. The corner is in physical centerline of road at the surface. There is a tree row to the east and a farm field to the west.


Witness found: From items 1, 2, 3 & 4
N 85°E 56.89' Power Pole.
S 65° E 29.77' 12" Maple.

C. Description of monument for corner and accessories established to perpetuate locating the position of the corner:

A-6 We placed a standard Lapeer County Remonumentation Brass cap on the found 1/2" rerod stamped #30092 as the best location for this corner as accepted by the Professional Surveyors in this area.

- AZ 15° 384.81' To Southwest corner of foundation house # 2794.
- AZ 60° 191.08' Set mag nail with Lapeer remon. tag in South face of 25" Apple.
- AZ 90° 57.30' Set mag nail with Lapeer County remon. tag in South face utility pole.
- AZ 140° 30.38' Set mag nail with Lapeer County remon tag in Southwest face of 19" Maple.
- AZ 225° 21.42' Set 1/2" rerod with AEW traverse cap.
- AZ 315° 20.05' Set 1/2" rerod with AEW traverse cap.
- South 89.23 to M-6 T8N, R11E
- North 2659.60 to A-5
- South 2643.23 to A-7

Signed by *Shelby W. Money* Date 12/29/99
Surveyor's Michigan License No. 30092

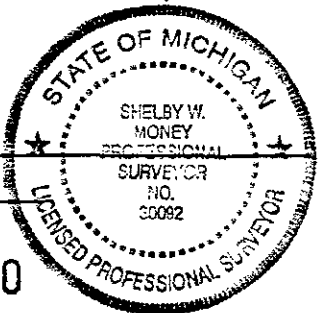

PEEP GROUP
APPROPRIATE LAND CORNER
[Signature]
DATE 11-10-99