

MAR 23 2000

SECTION

RECEIVED FOR RECORD

00 JAN 19 AM 8:49

REMONUMENTATION

LAND CORNER RECORDATION CERTIFICATE  
Filing Requirement of Act 74, Mich. P.A. 1970  
GOODLAND TOWNSHIP

Melissa DeVaugh  
REGISTER OF DEEDS  
LAPEER COUNTY MICHIGAN

For corners in

<u>LAPEER</u>	Located In:	Corner Code #
(County)		
1. Public Land Survey	<u>T 8 N R 12 E</u>	<u>A-8</u>
	T _____ R _____	_____
	T _____ R _____	_____
	T _____ R _____	_____
2. Property Controlling in Section	S _____ T _____ R _____	_____
	S _____ T _____ R _____	_____
3. Miscellaneous Property in Sec.	S _____ T _____ R _____	_____
	S _____ T _____ R _____	_____

469

Register of Deeds Stamp & File Number

4. Lot No. \_\_\_\_\_, Recorded Plat \_\_\_\_\_  
5. Private Claims \_\_\_\_\_

I, SHELBY W. MONEY, in a field survey on September 25, 19 99 do hereby certify that under requirements of P.A. 74, Michigan P.A. of 1970, the corner points mentioned in lines 1 and 2 above were in conformance with regulations and rules therefore as required in the current manual of survey instructions of the United States Department of the Interior, Bureau of Land Management or by a decree of a Court of Law and /or that the corner points mentioned in lines 3, 4 and 5 above were in conformance with the rules of the Michigan Board of Land Surveyors or by a Decree of a Court of Law; established, re-established, monumented, re-monumented, recovered, found as expressed below:

	A	B	C	D	E	F	G	H	I	J	K	L	M
1													
2		6		5		4		3		2		1	
3													
4		7		8		9		10		11		12	
5													
6		18		17		16		15		14		13	
7													
8		19		20		21		22		23		24	
9													
10		30		29		28		27		26		25	
11													
12		31		32		33		34		35		36	
13													

NOTE: Not more than 4 corners, all in the same town and range, may be recorded on this certificate.

A. Description of original monument and accessories and/or subsequent restoration:

- GLO 1816 Joseph Wampler Set post No witnesses remain
- 1. L1, Pg 255, January 1972 survey by Bernard Henderson, Not identified, A-8, T8N, R12E
- 2. L2, Pg 475, October 1973 survey by Robert G. Kay, Not identified, A-8, T8N, R12E

B. Description of corner evidence found and/or method applied in restoring or reestablishing corner:

Found no evidence of previous corner referenced in recorded surveys. Reestablished position using irons found at northeast corner of Parcel A of survey in L 1, Pg 255 and irons at west line of Parcel B of survey in L2, Pg475. Established position measures 74.09' south to M-8 of T8N, R11E. Recorded on Survey as 74.14'


C. Description of monument for corner and accessories established to perpetuate locating the position of the corner:

A-8 We placed a standard Lapeer County Remonumentation Brass cap on a rerod at the corner stamped #30092 as the best location for this corner as accepted by the Professional Surveyors in this area.

- AZ 15° 113.68' Set PK nail with Lapeer remon tag in west face 22" Cherry.
- AZ 95° 51.96' Set mag nail with Lapeer remon tag in south face of a utility pole.
- AZ 160° 49.26' Set mag nail with Lapeer remon tag in southwest face triple 18" Cherry.
- AZ 275° 43.53' Set mag nail with Lapeer remon tag in north face twin 14" Cherry.
- AZ 350° 110.81' Set mag nail with Lapeer remon tag in northeast face 9" Cherry.
- South 74.09' M-8, T8N, R11E
- North 2660.43 to A-7
- South 2649.71 to A-9

PEER GROUP  
APPROVED LAND CORNER  
STATE OF MICHIGAN  
LAPEER COUNTY  
RAY D. WINS P.S. CO. SURVEYOR  
DATE 11-10-99

Signed by Selby W. Money  
Surveyor's Michigan License No. 30092

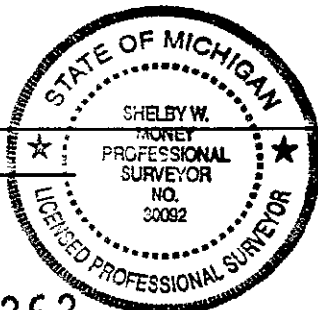

Date 12/29, 1999