

**SURVEY &  
REMONUMENTATION**

**MAR 23 2000**

RECEIVED FOR RECORD

00 JAN 19 AM 8:49

**SECTION**

**REMONUMENTATION**

**LAND CORNER RECORDATION CERTIFICATE  
Filing Requirement of Act 74, Mich. P.A. 1970  
GOODLAND TOWNSHIP**

*Melina DeVaugh*  
REGISTER OF DEEDS  
LAPEER COUNTY, MICHIGAN

For corners in

LAPEER Located In: Corner Code #  
(County)

- |                                       |         |                     |             |
|---------------------------------------|---------|---------------------|-------------|
| 1. Public Land Survey                 |         | <u>T 8 N R 12 E</u> | <u>A-10</u> |
|                                       |         | T _____ R _____     | _____       |
|                                       |         | T _____ R _____     | _____       |
|                                       |         | T _____ R _____     | _____       |
| 2. Property Controlling<br>in Section | S _____ | T _____ R _____     | _____       |
|                                       | S _____ | T _____ R _____     | _____       |
| 3. Miscellaneous<br>Property in Sec.  | S _____ | T _____ R _____     | _____       |
|                                       | S _____ | T _____ R _____     | _____       |

471

Register of Deeds Stamp & File Number

4. Lot No. \_\_\_\_\_, Recorded Plat \_\_\_\_\_  
5. Private Claims \_\_\_\_\_

I, SHELBY W. MONEY, in a field survey on September 25, 19 99 do hereby certify that under requirements of P.A. 74, Michigan P.A. of 1970, the corner points mentioned in lines 1 and 2 above were in conformance with regulations and rules therefore as required in the current manual of survey instructions of the United States Department of the Interior, Bureau of Land Management or by a decree of a Court of Law and /or that the corner points mentioned in lines 3, 4 and 5 above were in conformance with the rules of the Michigan Board of Land Surveyors or by a Decree of a Court of Law; established, re-established, monumented, re-monumented, recovered, found as expressed below:

|    | A  | B | C | D  | E | F | G  | H | I | J  | K | L  | M  |
|----|----|---|---|----|---|---|----|---|---|----|---|----|----|
| 1  |    |   |   |    |   |   |    |   |   |    |   |    |    |
| 2  | 6  |   |   | 5  |   |   | 4  |   |   | 3  |   | 2  | 1  |
| 3  |    |   |   |    |   |   |    |   |   |    |   |    |    |
| 4  | 7  |   |   | 8  |   |   | 9  |   |   | 10 |   | 11 | 12 |
| 5  |    |   |   |    |   |   |    |   |   |    |   |    |    |
| 6  | 18 |   |   | 17 |   |   | 16 |   |   | 15 |   | 14 | 13 |
| 7  |    |   |   |    |   |   |    |   |   |    |   |    |    |
| 8  | 19 |   |   | 20 |   |   | 21 |   |   | 22 |   | 23 | 24 |
| 9  |    |   |   |    |   |   |    |   |   |    |   |    |    |
| 10 | 30 |   |   | 29 |   |   | 28 |   |   | 27 |   | 26 | 25 |
| 11 |    |   |   |    |   |   |    |   |   |    |   |    |    |
| 12 | 31 |   |   | 32 |   |   | 33 |   |   | 34 |   | 35 | 36 |
| 13 |    |   |   |    |   |   |    |   |   |    |   |    |    |

**NOTE: Not more that 4 comers, all in the same town and range, may be recorded on this certificate.**

A. Description of original monument and accessories and/or subsequent restoration:

GLO Not set by the GLO  
County Surveyor Bates identified a stone 20x14x10 in 1864.

B. Description of corner evidence found and/or method applied in restoring or reestablishing corner:


Found a 60 penny nail in Summers Road (gravel). Farm field to the east, ownership extending into the Northwest and Southwest quarters of Section 30. No recorded evidence exists that referenced the nail. The Lapeer County Road Commission excavated to a depth 2' in the area. No stone could be found. We placed a iron with Remonumentation cap at the split between A-9 and A-11 on line Between M-9 and M-10 of T8n, R11E.

C. Description of monument for corner and accessories established to perpetuate locating the position of the corner:

A-10 We replaced the nail with 1/2" rebar with a standard Lapeer County Remonumentation Brass cap stamped #30092 as the best location for this corner as accepted by the Professional Surveyors in this area.

- AZ 170° 286.39' Set mag nail with Lapeer remon tag in West face of 15" Maple.
- AZ 200° 84.11' Set mag nail with Lapeer County remon tag in Southeast face of fence post.
- AZ 255° 34.96' Found iron with cap # 41101.
- AZ 315° 65.52' Set mag nail with Lapeer County remon tag in Northeast face, 11" Pine.
- AZ 305° 25.73' Notch in top of South end 12" CMP under gravel drive.
- South 77.15' to M-10, T8N, R11E.
- North 2638.26 to A-9
- South 2638.26 to A-11

Signed by *Shelby W. Money*  
Surveyor's Michigan License No. 30092

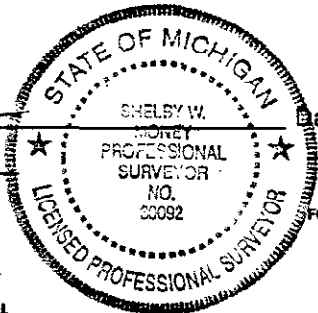

Date 12/29/99