

SURVEY & REMONUMENTATION

MAR 23 2000

RECEIVED FOR RECORD

00 JAN 19 AM 8:49

REMONUMENTATION

SECTION

LAND CORNER RECORDATION CERTIFICATE
Filing Requirement of Act 74, Mich. P.A. 1970
GOODLAND TOWNSHIP

Melissa DeVaugh
REGISTER OF DEEDS
LAPEER COUNTY MICHIGAN

For corners in

Form with fields for LAPEER (County), Located In: T 8 N R 12 E, Corner Code # A-11, and sections for Public Land Survey, Property Controlling in Section, and Miscellaneous Property in Sec.

472

Register of Deeds Stamp & File Number

4. Lot No. , Recorded Plat
5. Private Claims

I, SHELBY W. MONEY, in a field survey on September 25, 19 99 do hereby certify that under requirements of P.A. 74, Michigan P.A. of 1970, the corner points mentioned in lines 1 and 2 above were in conformance with regulations and rules therefore as required in the current manual of survey instructions of the United States Department of the Interior, Bureau of Land Management or by a decree of a Court of Law and /or that the corner points mentioned in lines 3, 4 and 5 above were in conformance with the rules of the Michigan Board of Land Surveyors or by a Decree of a Court of Law; established, re-established, monumented, re-monumented, recovered, found as expressed below:

NOTE: Not more than 4 corners, all in the same town and range, may be recorded on this certificate.

Grid table with columns A-M and rows 1-13, containing numbers 1-36.

A. Description of original monument and accessories and/or subsequent restoration:

- GLO 1816 Joseph Wampler Set post No witnesses remain
1. L1, Pg 69, August 1971, survey by Robert G. Kay, Not identified A-11, T8N, R12E
2. L6, Pg 213, December 1980, survey by Charles S. Getz. Found 3/8" iron. A-11, T8N, R12E
3. L6, Pg 214, November 1980, survey by Charles S. Getz. Found 3/8" iron. A-11, T8N, R12E

Signature and date 11-10-99

B. Description of corner evidence found and/or method applied in restoring or reestablishing corner:


Found a 1/2" reroed in Summers Road (gravel) road at the intersection with Utley Road (gravel) to the East. The corner is 4' west of the physical centerline of Summers road and 2' north of the physical centerline of Utley road, 6" below surface.

C. Description of monument for corner and accessories established to perpetuate locating the position of the corner:

A-11 We placed a standard Lapeer County Remonumentation Brass cap on a reroed at the corner stamped #30092 as the best location for this corner as accepted by the Professional Surveyors in this area.

- AZ 110° 125.85' Set mag nail with Lapeer remon tag in north face of triple 18" Oak.
AZ 150° 83.84' Set mag nail with Lapeer remon tag in southwest face 6" Boxelder.
AZ 200° 113.83' Found nail with tag in east face of 18" Oak
AZ 350° 117.55' Set mag nail with Lapeer remon tag in west face of utility pole, below fnd PK.
South 75.21' M-11, T8N, R11E
North 2638.26' to A-10
South 2681.61' to A-12

Signed by Shelby W. Money
Surveyor's Michigan License No. 30092

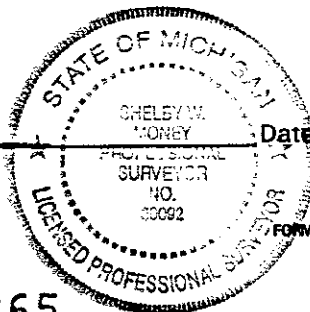

Date 12/29, 1999