

SURVEY &
REMONUMENTATION

MAR 23 2000

REMONUMENTATION

RECEIVED FOR RECORD

00 JAN 19 AM 8:49

Melissa De Vaughn

REGISTER OF DEEDS
LAPEER COUNTY MICHIGAN

SECTION

LAND CORNER RECORDATION CERTIFICATE
Filing Requirement of Act 74, Mich. P.A. 1970
GOODLAND TOWNSHIP

For corners in

LAPEER (County)	Located In:	Corner Code #
1. Public Land Survey	T 8 N R 12 E	A-12
	T R	
	T R	
	T R	
2. Property Controlling in Section	S T R	
	S T R	
3. Miscellaneous Property in Sec.	S T R	
	S T R	

473

Register of Deeds Stamp & File Number

4. Lot No. _____, Recorded Plat _____
5. Private Claims _____

I, SHELBY W. MONEY, in a field survey on September 25, 19 99 do hereby certify that under requirements of P.A. 74, Michigan P.A. of 1970, the corner points mentioned in lines 1 and 2 above were in conformance with regulations and rules therefore as required in the current manual of survey instructions of the United States Department of the Interior, Bureau of Land Management or by a decree of a Court of Law and /or that the corner points mentioned in lines 3, 4 and 5 above were in conformance with the rules of the Michigan Board of Land Surveyors or by a Decree of a Court of Law; established, re-established, monumented, re-monumented, recovered, found as expressed below:

	A	B	C	D	E	F	G	H	I	J	K	L	M
1													
2	6		5		4		3		2				
3													
4	7		8		9		10		11		12		
5													
6	18		17		16		15		14		13		
7													
8	19		20		21		22		23		24		
9													
10	30		29		28		27		26		25		
11													
12	31		32		33		34		35		36		
13													

NOTE: Not more than 4 corners, all in the same town and range, may be recorded on this certificate.

A. Description of original monument and accessories and/or subsequent restoration:

GLO Not set by GLO

- L1, Pg 69, August 1971 survey by Kay Engineering, Not identified. A-12, T8N, R12E
- L4, Pg 699, May 1978 survey by Henderson Bates, Found 1/2" iron. A-12, T8N, R12E
- L6, Pg 561, August 1983 survey by Earl Gravin, Found 1/2" iron. A-12, T8N, R12E
- L6, Pg 213, survey by Kay Engineering, Found 1/2" iron. A-12, T8N, R12E
- L6, Pg 214 November 1980 survey by Kay Engineering, Found 1/2" iron. A-12, T8N, R12E

B. Description of corner evidence found and/or method applied in restoring or reestablishing corner:


Found a 1/2" rod in Summers Road (gravel) road. The corner is 4.5' west of the physical centerline of road 3' below the surface. There is a barbed wire fence to the east

C. Description of monument for corner and accessories established to perpetuate locating the position of the corner:

A-12 We placed a standard Lapeer County Remonumentation Brass cap on a reroed at the corner stamped #30092 as the best location for this corner as accepted by the Professional Surveyors in this area.

- AZ 40° 65.12' Set mag nail with Lapeer remon tag in south face of a utility pole, 2.8' below fnd PK.
- AZ 135° 41.10' Set mag nail with Lapeer remon tag in southwest face triple 12" Maple.
- AZ 210° 38.49' to notch cut in top of north end of 12" cmp culvert under drive to house # 1245.
- AZ 220° 84.44' Found PK in east face of 9" Pine.
- AZ 100° 33.25' Found iron with cap # 18886.
- South 74.09' M-8, T8N, R11E
- North 2681.61' to A-11
- South 2660.35' to A-13

Signed by Shelby W. Money
Surveyor's Michigan License No. 30092

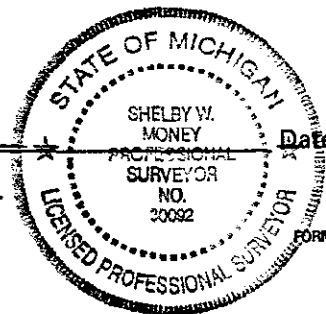

Date 12/29, 1999