

**SURVEY &
REMONUMENTATION**

APR 29 1996

COMMISSION

LAND CORNER RECORDATION CERTIFICATE

Filing Requirement of Act 74, Mich. P.A. 1970

RECEIVED FOR RECORD

For corners in
LAPEER
County

Located In:
GOODLAND TOWNSHIP

Corner Code #

95 DEC 28 PM 2:39

LIBER NO. 005 PAGE NO. 326
Richard D. Bailey
REGISTER OF DEEDS
LAPEER COUNTY, MICHIGAN

1. Public Land Survey	T	<u>8N</u>	R	<u>12E</u>	<u>M-5</u>
	T		R		
	T		R		
	T		R		
2. Property Controlling in Section	S		T		
	S		T		
3. Miscellaneous Property in Section	S		T		
	S		T		

Register of Deeds Stamp & File Number

4. Lot No. _____, Recorded Plat _____
5. Private Claims _____

I, James T. Bailey, in a field survey on December 21, 19 95, do hereby certify that under requirements of P.A. 74, Michigan P.A. of 1970, the corner points mentioned in lines 1 and 2 above were in conformance with regulations and rules therefore as required in the current manual of survey instructions of the United States Department of the Interior, Bureau of Land Management or by a decree of a Court of Law and/or that the corner points mentioned in lines 3, 4 and 5 above were in conformance with the rules of the Michigan Board of Professional Surveyors or by a Decree of a Court of Law; established, re-established, monumented, re-monumented, recovered, found as expressed below:

A	B	C	D	E	F	G	H	I	J	K	L	M
2	6	5	4	3	2	1						
3												
4	7	8	9	10	11	12						
5												
6	18	17	16	15	14	13						
7												
8	19	20	21	22	23	24						
9												
10	30	29	28	27	26	25						
11												
12	31	32	33	34	35	36						
13												

NOTE: Not more than 4 corners, all in the same town and range, may be recorded on this certificate.

A. Description of original monument and accessories and/or subsequent restoration:

- G.L.O. (1822) WAMPLER D.S. SET POST NO WITNESSES FOUND
- L.C.R.C. (2/28/83) DAVIS P.S. L.4 P.61 SET PK NAIL IN CONC DECK BY SINGLE PROPORTIONATE MEASUREMENT

B. Description of corner evidence found and/or method applied in restoring or reestablishing corner:

1995 JAMES T. BAILEY P.S. FOUND PK NAIL PER ITEM #2 ABOVE TO BE OBLITERATED. LOCATED CORNER BY SINGLE PROPORTIONATE MEASUREMENT AND SET LAPEER COUNTY REFERENCE MONUMENTS 30.50 FEET NORTH AND 30.50 FEET SOUTH OF M-5 ON SECTION LINE BETWEEN M-4 and M-6.

DISTANCES


M-5 - M-4 2635.15
M-5 - M-6 2635.15

PEER GROUP
APPROVED LAND CORNER
PA 345 OF 1990
LAPEER COUNTY

Ray D. Bailey
RAY DAVIS P.S. NO. SURVEYOR
DATE 8-31-95

C. Description of monument for corner and accessories established to perpetuate locating the position of the corner:

SET LAPEER COUNTY REFERENCE CAP ON 1/2" ROD 30.50 FEET NORTH OF M-5 SOUTH 61.00 LAPEER COUNTY REF MON.
S.45°E. 75.42 SET PK NAIL W/ REMON TAG IN 12" OAK
S.20°E. 89.97 SET PK NAIL W/ REMON TAG IN 10" POPLAR
S.10°W. 19.94 N.E. COR. OF W'LY HEAD WALL
SET LAPEER COUNTY REFERENCE CAP ON 1/2" ROD 30.50 FEET SOUTH OF M-5 NORTH 61.00 LAPEER COUNTY REF. MON.
N.30°E. 33.71 S.W COR E'LY HEAD WALL
N.80°E. 55.48 SET PK NAIL W/ REMON TAG IN 12" OAK
S.60°E. 37.79 SET PK NAIL W/ REMON TAG IN 10" POPLAR

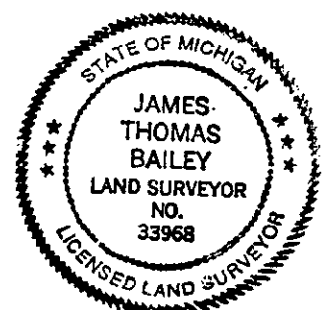

Signed by *J. Bailey* Date DECEMBER 22, 1995

Surveyor's Michigan License No. 33968