

SURVEY & REMONUMENTATION

APR 29 1996

COMMISSION

LAND CORNER RECORDATION CERTIFICATE

Filing Requirement of Act 74, Mich. P.A. 1970

RECEIVED FOR RECORD

For corners in LAPEER County

Located In: GOODLAND TOWNSHIP

Corner Code #

- 1. Public Land Survey T 8N R 12E M-6
2. Property Controlling in Section S T R
3. Miscellaneous Property in Section S T R

95 DEC 28 PM 2:40
LIBER NO. 005 PAGE NO. 327
REGISTER OF DEEDS LAPEER COUNTY MICHIGAN

Register of Deeds Stamp & File Number

- 4. Lot No.
5. Private Claims

Grid table with columns A-L and rows 1-13, containing numbers 1-36.

I, James T. Bailey, in a field survey on December 6, 1995, do hereby certify that under requirements of P.A. 74, Michigan P.A. of 1970, the corner points mentioned in lines 1 and 2 above were in conformance with regulations and rules therefore as required in the current manual of survey instructions of the United States Department of the Interior, Bureau of Land Management or by a decree of a Court of Law and/or that the corner points mentioned in lines 3, 4 and 5 above were in conformance with the rules of the Michigan Board of Professional Surveyors or by a Decree of a Court of Law; established, re-established, monumented, re-monumented, recovered, found as expressed below:

NOTE: Not more than 4 corners, all in the same town and range, may be recorded on this certificate.

A. Description of original monument and accessories and/or subsequent restoration:

- 1. G.L.O. (1822) WAMPLER D.S. SET POST NO WITNESSES FOUND
2. L.C.R.C. (2/28/83) DAVIS P.S. L.4 P.61 SET 1/2" BAR INSIDE EXISTING PIPE

B. Description of corner evidence found and/or method applied in restoring or reestablishing corner:

1995 JAMES T. BAILEY P.S. FOUND A 1/2" IRON BAR 0.15 BELOW GRADE 5' WEST OF THE CENTERLINE OF CADE ROAD (GRAVEL) AT THE CENTERLINE OF KOHLER ROAD (GRAVEL). WITNESSES FROM ITEM #2 ABOVE MATCH.


PEEP GROUP APPROVED LAND CORNER PAID \$10.00 LAPEER COUNTY

JAMES T. BAILEY SURVEYOR DATE 8-31-95

C. Description of monument for corner and accessories established to perpetuate locating the position of the corner:

M-6 SET STANDARD LAPEER COUNTY REMONUMENTATION CAP ON FOUND 1/2" IRON BAR.

- N.50°E. 101.96 SET PK NAIL W/ REMON TAG IN POWER POLE
S.75°E. 43.60 SET PK NAIL W/ REMON TAG IN 8" ELM
S.30°E. 72.43 SET PK NAIL W/ REMON TAG IN 36" MAPLE
S.45°W. 47.41 SET PK NAIL W/ REMON TAG IN 10" BOX ELDER

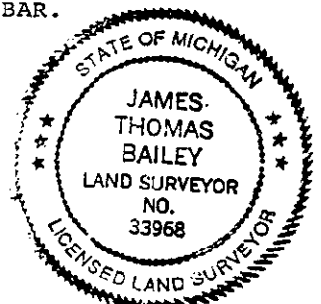

Signed by [Signature] Surveyor's Michigan License No. 33968

Date DECEMBER 20, 1995